Township No. 44 N., Range No. 5 West Mer. (Mich.)

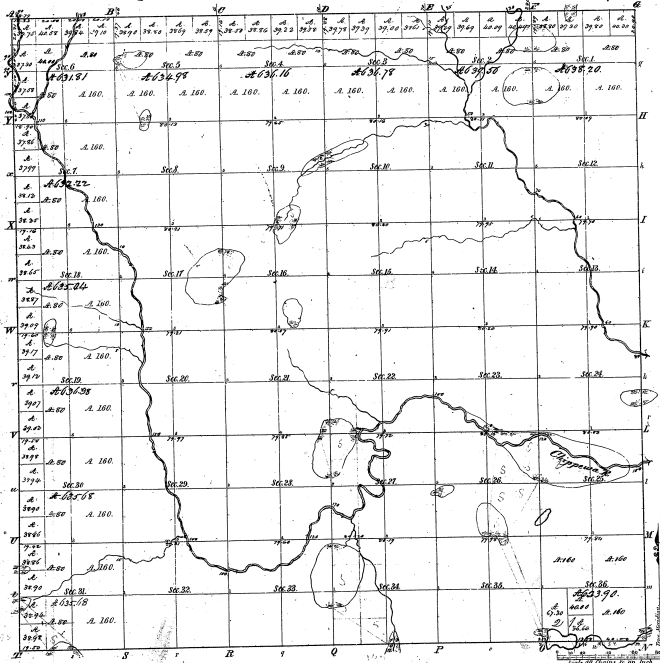

Meanders of Part of a Lake in Section 36.

Posts	Courses	Ch. Lks.	Posts	Courses	Ch. Lks.	Posts	Courses	Ch. Lks.
2	S 20 E	3.00						
	S 75 E	4.50						
	N 80 E	5.00						
	S 70 E	5.00						
	S 49 E	5.00						
	S 72 E	6.00						
	S 43 E	4.00						
	S 23 E	3.00						
1	N 75 W	1.90						

Total number of Acres 22,276.39

Surveys Designated	By Whom Surveyed	Date of Contract	Amount of Surveys	When Surveyed	When plat was sent to the Surveyor Gen'l's Office
Township lines	Solon Chaffee	April 11, 1827	23-70-00	E. 1827	E. 1828
Subdivisions	H. Whitbeck	July 11, 1838	62.32.33	W. 1831	W. 1839

The above Map of Township No. 44 N of Range No. 5 W of the Principal Meridian Michigan is strictly conformable to the field-notes of the surveys thereof on file in this Office, which have been examined and approved.

Surveyor General's Office
Cincinnati, Feb. 22, 1839

C. S. Sibley Surv. Gen'l