Resurvey

# Township No. 26 N. Range No. 5 W. Mer. Mich.

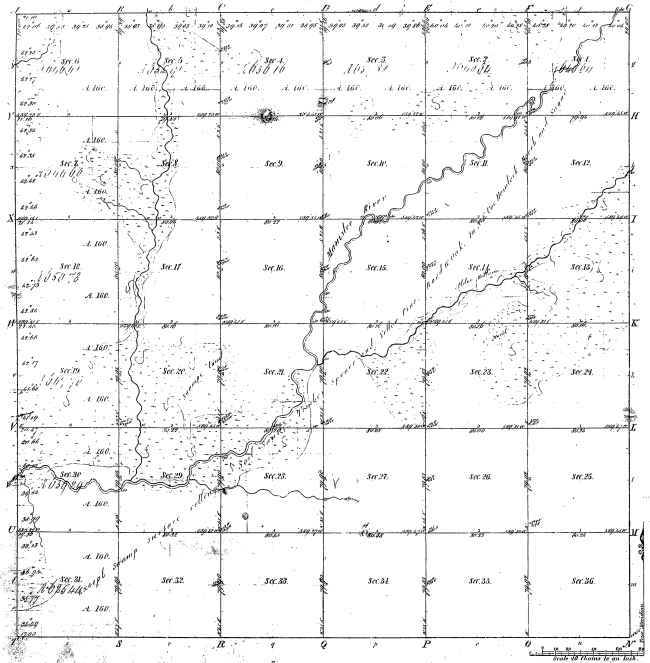


| Meanders of | | | |
|---|---|---|---|
| Posts Courses | Chs. Lks. | Posts Courses | Chs. Lks. |
| | | | |

15-2

Total number of Acres. 23,050.55

| Surveys Designated. | By Whom Surveyed | Date of Contract | Amount of Surveys | When Surveyed | When & to whom in the Int. Gen. Off. |
|---|---|---|---|---|---|
| Township lines | Mahlette Brevoort | May 10 1846 | M. 24 - 20 | Oct. 6th 1846 | |
| Subdivisions | Geo. H. Cannon | April 7th 1853 | 24 - 05 - 40 | 1st Mar. 1853 | |

The above Map of Township No. 26 North of Range No. 5 West of the Principal Meridian Michigan is strictly conformable to the field notes of the survey thereof on file in this Office which have been examined and approved.

Surveyor General's Office
Detroit June 21 1853

Edwin Chapman
Surv. Genl.