


Township N<sup>o</sup> VII north, Range N<sup>o</sup> VII East Mer. (Mid. Ter.)

113

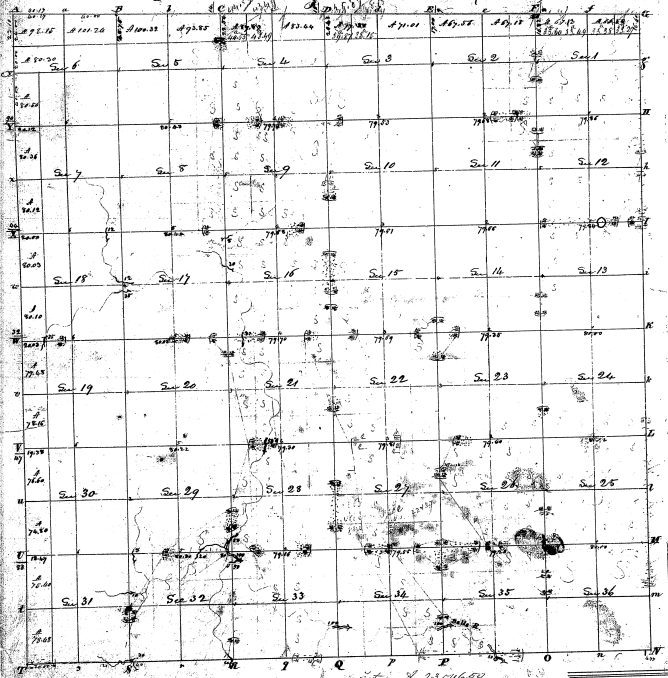

27-13

27-13



