Township No. VII North, Range No. X East of Mer. (Mich. Ter.)

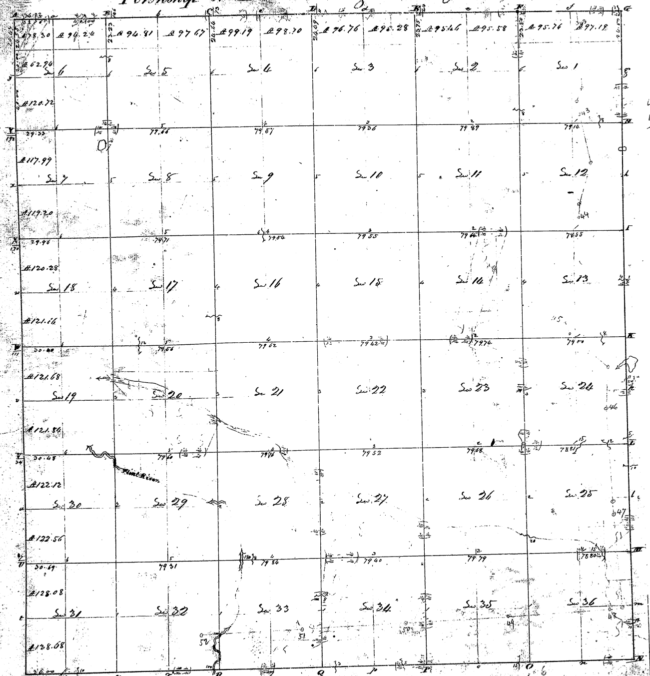

Acreage 22,196.19

Pursuant to a contract with and instructions from Edward Tiffin Surveyor General of the United States bearing date the day of I have admeasured laid out and surveyed the above Township, and do certify that it had such marks and bounds both natural and artificial as are represented on said plat and described in the field notes thereof and returned with the plat into the Surveyor General's Office. Certified this [illegible] day of April 1824

Sylvester Sibley D.S.

Surveyed in April 182[illegible]

27-10

27-10