# Township No. 32 N. Range No. 15 W. Mer. Mich.

Part of N. Manitou Island.

LAKE MICHIGAN

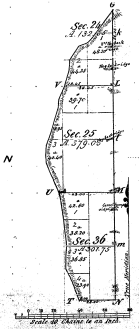


| Boundary of | | | | | | | | |
|---|---|---|---|---|---|---|---|---|
| Posts | Courses | Dist. Lks | Posts | Courses | Dist. Lks | Posts | Courses | Dist. Lks |
| | | | | | | | | |

48-20

Total number of Acres 873.35

| Survey Designated. | By Whom Surveyed. | Date of Contract. | Amount of Surveys. M. Ch. | When Surveyed. | When Changed in the Surv.Gen.s Ofc. |
|---|---|---|---|---|---|
| Township lines. | O. Sheldon. | Apl. 20th 1847 | 23.04.92 | Sept. 1847 | |
| Subdivisions. | O. Sheldon | " 1847 | 873.79.80 | Oct. & Nov. 1847 | |
| | | | | | |

The above Map of a survey in Detroit in Township No. 32 North of Range No. 15 West of the Principal Meridian Michigan is strictly conformable to the field notes of the survey thereof on file in this Office which have been examined and approved.

Surveyor General's Office
Detroit Mich. Oct. 18th 1848

Lucius Lyon Surv.r Genl.

48-20