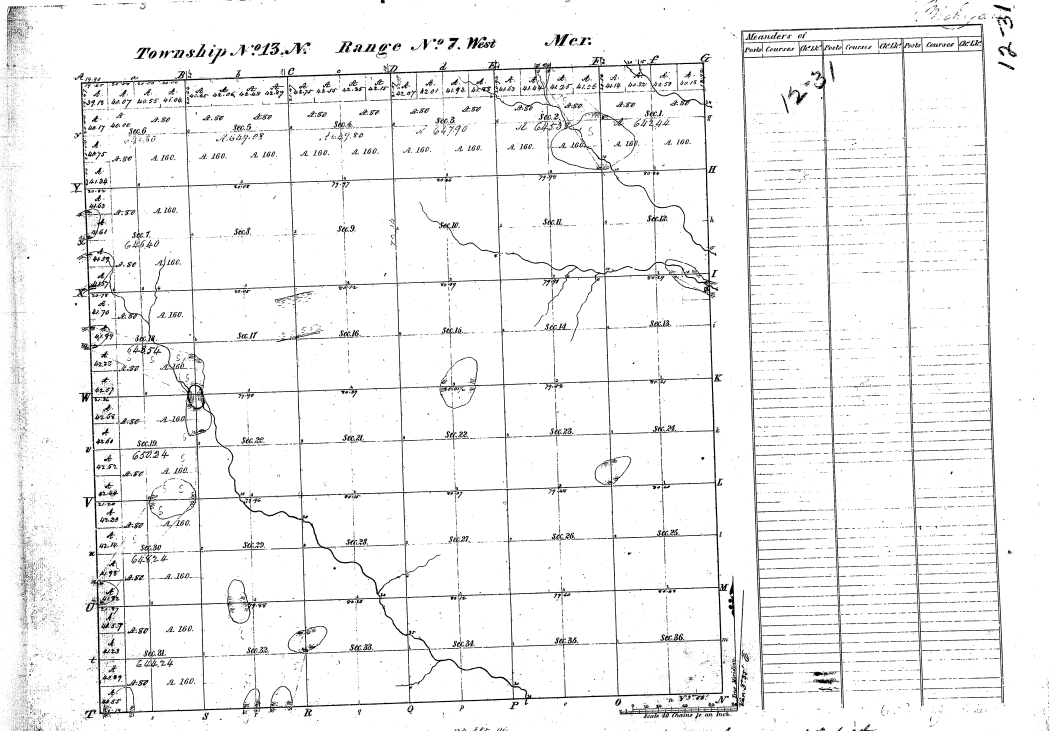

Surveys Represented	By Whom Surveyed	Date of Contract	Amount of Surveys	When Surveyed	When 4th and 8th on the Std Cors were run
Township lines and subdivisions	Nelson Hood sworn N. 13 W. 7 W.	June 12, 1837 July 22, 1838	23-115-06 22.07.71	Aug. 1837 Aug. 1839	Aug. 1837 Aug. 1839

Plat above Maps of Township N° 13 North of Range N° 7 West of the Principal Meridian Michigan as strictly conformable to the field notes of the survey thereof on file in this office which have been examined and approved

Surveyor Generals Office, Tecumseh July 6th 1839

S. Dea Sur. Genl