Island in Muskegon River

Township No. 15 N. Range No. 9 W. Mer. Mich.

Meanders of								
Posts	Courses	Chs. Lks.	Posts	Courses	Chs. Lks.	Posts	Courses	Chs. Lks.

11-21

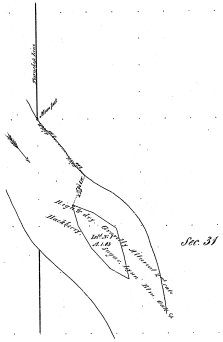

Scale 8 Chains to an Inch

Total number of Acres					
Survey Dongested.	By Whom Surveyed.	Date of Contract.	Amount of Surveys. M. Ch. Lks.	When Surveyed.	When Charged in the Stat. Bks. and ent.
Township lines.					
Subdivisions.	Thos. Whelpley	Instructions May 24. 1848		1850	

The above, sheet, is a Township 15 North of Range 9 West of the Principal Meridian, of Michigan is strictly conformable to the plat, also of the survey thereof on file in this Office, which have been examined and approved.

Surveyor Generals Office
Detroit April 18th 1857

L. S. Ensworth Asst. Sur. Genl.

11-21