Islands in Muskegon River

Township No. 15 N. Range No. 10 W. Mer. Mich.

11-22 ②

11-22

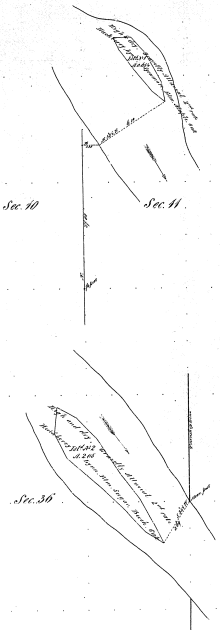

Meanders of								
Posts	Courses	Ch. Lks.	Posts	Courses	Ch. Lks.	Posts	Courses	Ch. Lks.

Total number of Acres

Surveys designated.	By Whom Surveyed.	Date of Contract.	Amount of Surveys M. Ch. Lks.	When Surveyed.	When Changed to the Sur. Gen. Off.
Township lines.					
Subdivisions.	The Whole	Instructions May 24 1854		1850	

The above Map of Township No. 15 North of Range No. 10 West of the Principal Meridian, of Michigan, is strictly conformable to the field notes of the survey thereof on file in this Office, which have been examined and approved.

Surveyor Generals Office, Detroit, April 15 1857. Robt. Emmerson Surv. Genl.