Resurvey

Township No. 13 N. Range No. 2 W. Mer. Mich.

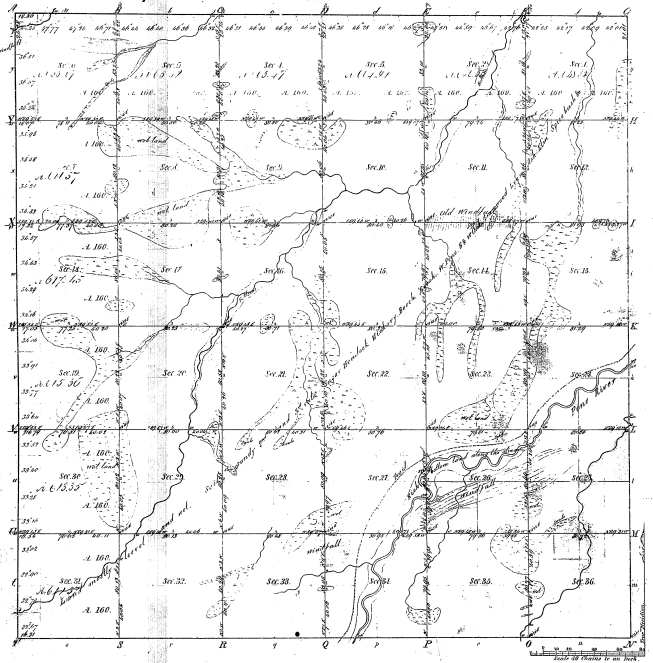

Meanders of

Pub. Courses Ch. Lks.	Pub. Courses Ch. Lks.	Pub. Courses Ch. Lks.

13-31

The tracts shaded on this plat are lands that were sold prior to the Resurvey.

Total number of Acres. 23,035.12

Surveys Designated.	By Whom Surveyed	Date of Contract	Amount of Surveys	When Surveyed	When the Sur. Gen. Ls. in the Sur. Gen. Office
Township lines	Robert Clark Jr.	Nov 17. 1830	W. 26 / 27 - 52	2nd Quar. 1832	
Subdivisions	Austin Bent	April 15. 1852	W. 26 / 27 - 52	2nd Quar. 1852	

The above Map of Township No. 13 North of Range No. 2 West of the Principal Meridian Michigan is strictly conformable to the field notes of the survey thereof on file in this Office which have been examined and approved.

Surveyor General's Office
Feby. 17th A.D. 1853

Leander Chapman
Surv. Genl.

13-31

16