Resurvey.

Township. Nº 14 N. Range. Nº 1 W. Mer. Mich.

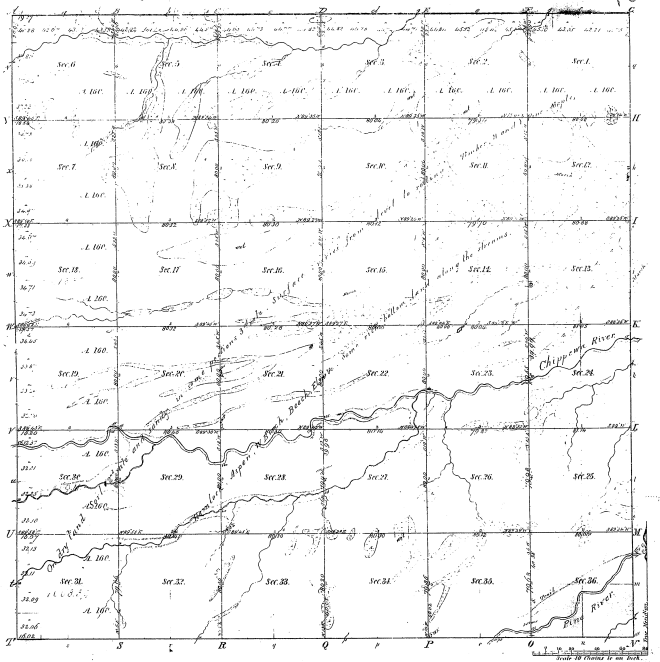

Meanders of
Pine Courses N°W. Pine Courses N°E. Pine Courses N°E.

The lands shaded thus are lands that have been sold May 1852

Total number of Acres 23014.26

Surveys Designated by	By Whom Surveyed	Date of Contract	Journal of Surveys	When Surveyed	When plats and notes to the Surveyor Gen'l were transmitted
Township Lines	Robert Clark Jr.	Nov 17 1830	1st Vol 169	2nd Quar 1831	
Subdivisions	Reuben Burt	April 15 1832	Do Do 62	3rd Quar 1832	

The above Map of Township 14 th North of Range 1 st West of the Principal Meridian Michigan is strictly conformable to the field notes of the survey thereof on file in this Office, which have been examined and approved.

Surveyor General's Office
Detroit June 30 1853

Surveyor Gen'l

13-25