14-2
14 Mich

Township No. 14 N, Range No. 2 East Mer. (Mich.)

23-27

23-27

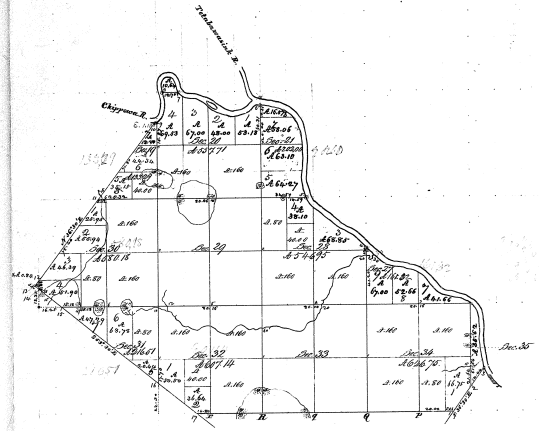

Meanders of Chippewa River.

Posts	Courses	Ch.s Lks	Posts	Courses	Ch.s Lks	Posts	Courses	Ch.s Lks
Bet. Sec. 1	Sec. 2	Mean						
1	S 27 E	1.10						
	N 57 E	2.00						
	N 32 E	7.00						
	N 5 E	5.00						
8	N 10 W	11.50						
	N 10 W	6.00						
	N 40 E	4.00						
	N 73 E	4.00						
	S 78 E	4.00						
7	S 30 E	10.00						
	S 20 E	1.50						
	S 60 E	4.00						
	S 75 E	14.00						
	S 57 E	12.00						
	S 68 E	12.00						
	N 88 E	5.00						
	N 72 E	6.00						
	N 59 E	12.00						
6	S 87 E	4.00						
	S 80 E	12.00						
	S 70 E	7.00						
	S 52 E	5.00						
	S 43 E	7.00						
	S 21 E	8.00						
	S 11 E	10.00						
	South	10.00						
	S 5 W	8.00						
	S 10 E	10.00						
5	S 27 E	3.60						
	S 86 E	11.00						
	S 54 E	27.00						
4	S 51 E	22.10						
	S 49 E	16.00						
	S 77 E	27.00						
	S 69 E	7.00						
	S 43 E	20.00						
	S 71 E	14.00						
	S 60 E	8.40						
	S 50 E	5.00						
	S 15 E	8.00						
	South	15.00						
3	S 7 E	24.80						

Total number of Acres 4958.95

Surveys Designated.	By Whom Surveyed.	Date of Contract.	Amount of Surveys M. Ch. Lks	When Surveyed.	When Charged in the Surv. Genl's acct.
Township lines.	John Mullett	Feb. 16. 1840	2. 42. 24	3d. yr. 1839	
Subdivisions.	Same		21. 31. 36		

The above Map of Township No. 14 N. of Range No. 2 East of the Principal Meridian, Mich. is strictly conformable to the field notes of the survey thereof on file in this Office, which have been examined and approved.

Surveyor Generals Office,
Cincinnati, May 23. 1840.

C. S. Ewing Surv. Genl.

6