


Township N. 21 North, Range N. 1 East Mer. (Misc. Ter.)

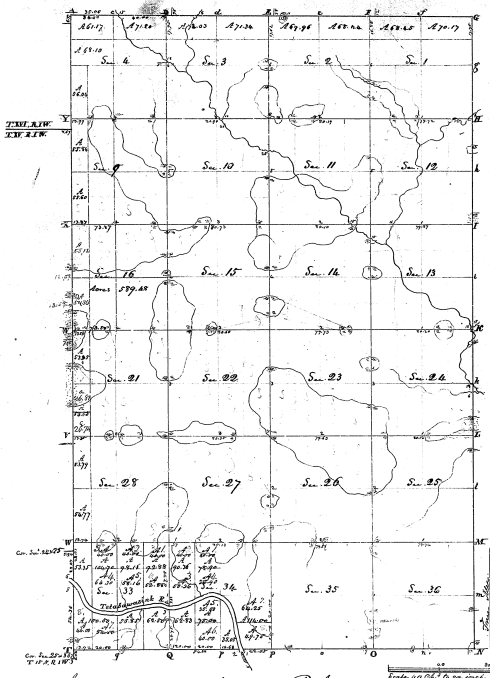

Surveyed in May 1831, by Henry Parker, D.S.

The above Map of Township N. 21 S. of Range N. 1 E. East of the principal Meridian (Misc. Ter.) is strictly conformable to the field notes of the Survey thereof, on file in this Office, which have been examined & approved.

Surveyor General's Office
 Cincinnati, Aug. 25th 1833

M. T. Williams
 Secy. Genl.

