15-33

(3)

Re-survey

Township No. 22 N Range No. 8 W Mer. Mich.

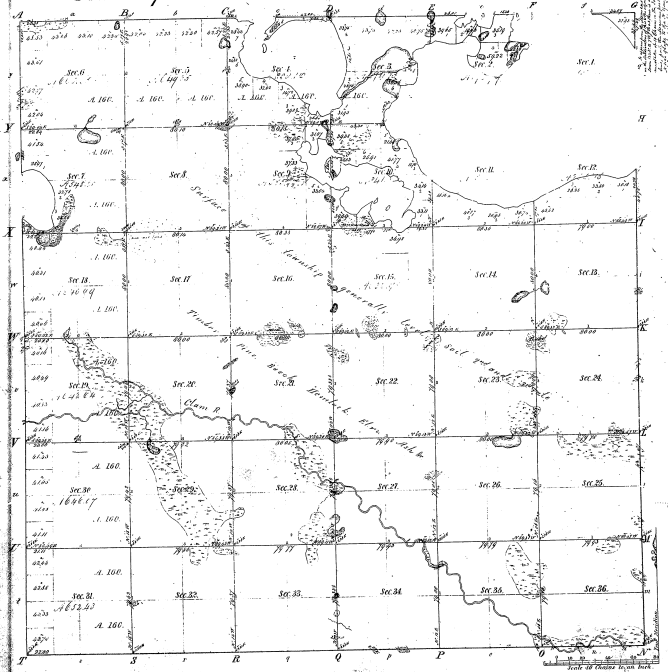

Meanders of						
Poals Courses	15th Lk.	Poals Courses	18th Lk.	Poals Courses	15th Lk.	

Total number of Acres. 20.214.48.

Survey assigned	By Whom Surveyed	Date of Contract	Amount of Surveys	When Surveyed	Whole 1st or 2nd or 3rd in the Sur. Dist. 2d Mer.
			M. Ch. Lks.		
Township lines	John Pierrak	Nov. 20th 1856	72 . 22 . 50	4th Quar. 1857	1
Subdivisions	W. L. Gaffenberg	April 22nd 1862	71 . 22 . 47	3rd Quar. 1859	

The above Map of Township No. 22 N. of Range No. 8 W of the Principal Meridian of Michigan is strictly conformable to the field notes of the survey thereof on file in this Office, which have been examined and approved.

Surveyor General's Office,
Detroit February 17 1864.

Leander Chapman
Sur. Genl.

15/33

(3)

15-33

PLAT OF AN ISLAND

in Secs. 1 and 2, T. 22 N., R. 8 W., P.M.,

MICHIGAN.

Surveyed by Walter E. Hoffman, U.S. Surveyor, September 27, 1912,
under special instructions from the Com'r G.L.O. bearing date June 28, 1912.

Scale : 20 chs. to an inch.

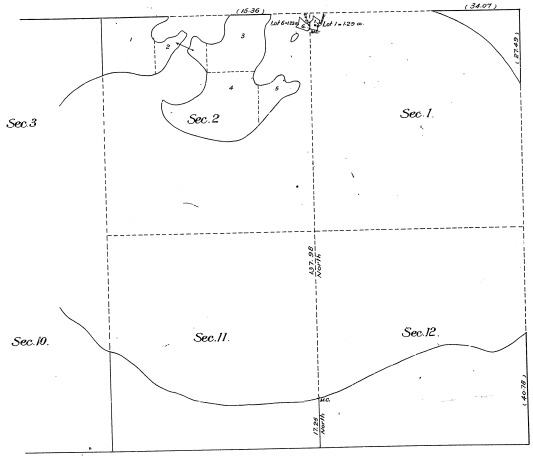

Department of the Interior,
General Land Office,
Washington, D.C., April 6, 1914.

The above is a correct plat of survey of an Island in Secs. 1 and 2, T. 22 N., R. 8 W., P.M., Michigan, executed by Walter E. Hoffman, U.S. Surveyor, in pursuance of special instructions from the Commissioner of the General Land Office, bearing date June 28, 1912, and is strictly conformable to the field notes of survey thereof on file in this office, which have been examined and approved.

Commissioner and ex officio
U.S. Surveyor General for Michigan.