Islands in Muskegon River

Township No. 12 N. Range No. 13 W. **Mer. Mich.**

10.36

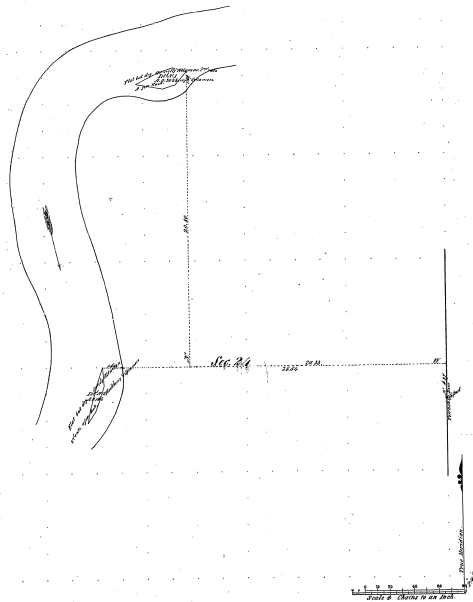

Meanders of								
Posts	Courses	Dist.	Posts	Courses	Dist.	Posts	Courses	Dist.

Total number of Acres

Surveys Designated.	By Whom Surveyed.	Date of Contract.	Journal of Surveys Returned	When Surveyed.	When Charged in the Gen'l Ledger.
Township Lines.					
Subdivisions.	Thos. Hinsdale	[illegible]		1848	

The above Map of Township No. 12 North of Range No. 13 West of the Principal Meridian, of Michigan is strictly conformable to the field notes of the survey returned in the Office, which have been examined and approved.

Surveyor General's Office, Detroit, Oct. 1st 1847

M. L. Fenton Surv. Genl.

10-36

10-36