


Township No. 18 North Range No. 9 West Mer. Mic.

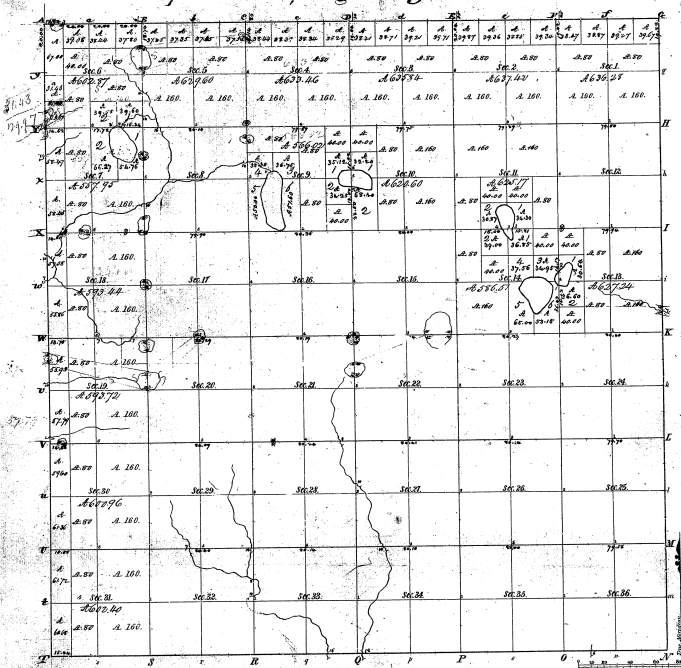




The above Map of Township No. 18 N. of Range No. 9 W. of the Principal Meridian, Michigan, is hereby referred to, in the full name of the survey thereof on file in this office, which has been examined and approved.
 Surveyor General's Office
 Grand Rapids, Dec. 2 1859
 [Signature]