Re Survey

Township No. 23 N. Range No. 1 W. Mer. Mich.

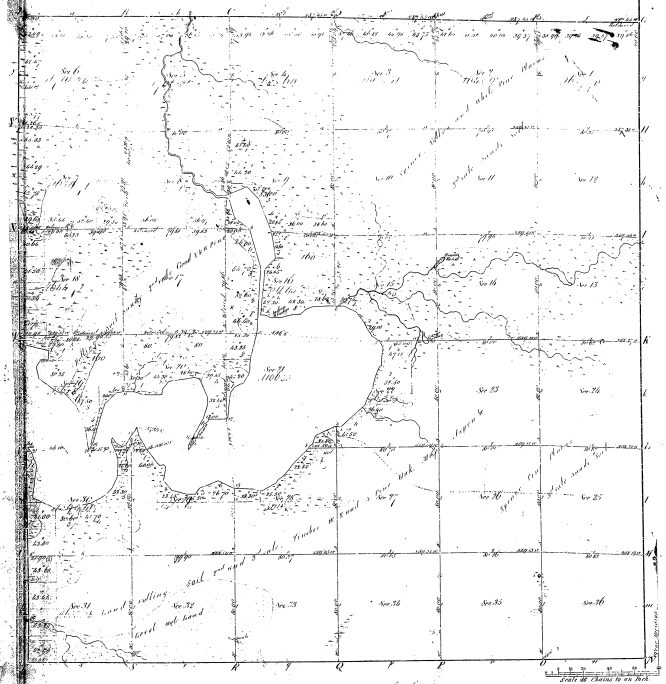

Total number of Acres 21160.60

Surveys Designated.	By Whom Surveyed.	Date of Contract.	Amount of Surveys. M. Ch. Lks.	When Surveyed.	When Charged in the Surv. Genl. Acct.
Township lines.	John Reinh	Nov. 16. 1836	19. 01. 42.	2nd Quar. 1838	
Subdivisions.	William Burt	April 20. 1852	70. 17. 18.	4th Quar. 1852	

The above Map of Township No. 23 North of Range No. 1 West of the Principal Meridian, Michigan is strictly conformable to the field notes of the survey thereof on file in this Office, which have been examined and approved.

Surveyor General's Office, Detroit Feb. 10. 1853

Attest. Jas. Robb Sur. Genl.

14-29

14-29

16