



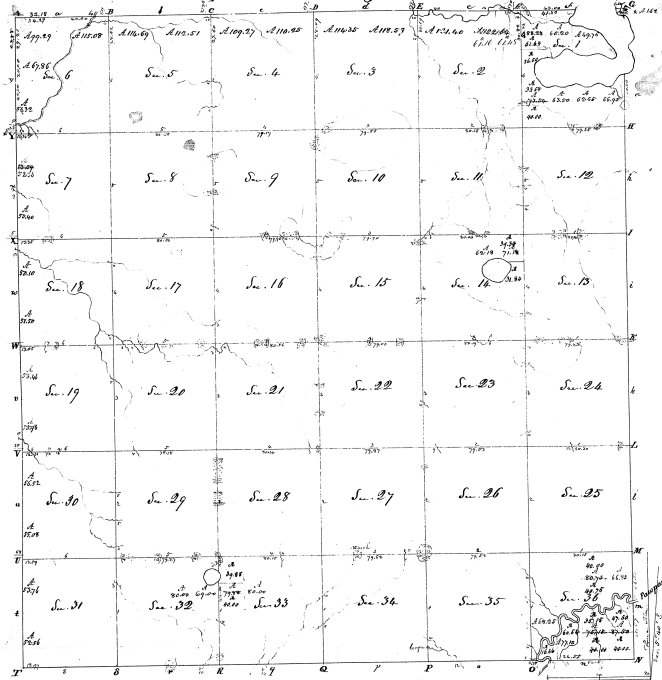

Contents		Balance	
No. Acres	Value	No. Acres	Value

Surveyed in January & February 1830, by Geo. W. Harrison & Co.