Township N. III South, Range XIII West Mer. (Mic. Ter.)

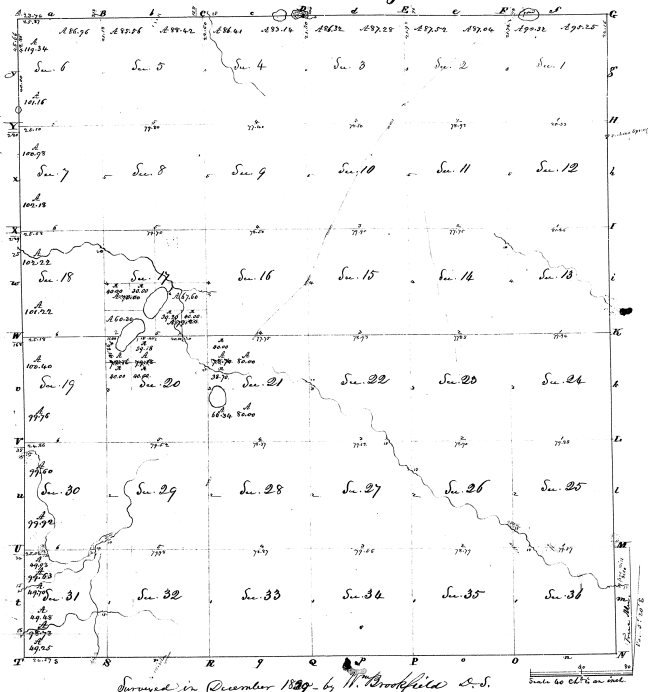

Surveyed in December 1839 by W. Brookfield D.S.

Scale 60 Ch. to an inch

Counties Co.				Counties Co.			
Declared		Acres	Hds.	Declared		Acres	Hds.
NE	NE 1	98	25	E½	19	320	
SE	" "	80		NW	"	100	00
NE	NW "	98	32	SW	"	79	76
SE	" "	80		NE	20	160	
	SE "	320	00	E½	NW "	79	18
NE	NE 2	98	04	W½	" "	72	16
SE	" "	80		E½	"	320	
NE	NW "	97	52	E½	21	320	
SE	" "	80		E½	NW "	80	
	E½ "	320		W½	" "	78	70
NE	NE 3	87	28	E½	SW "	80	
SE	" "	80		W½	" "	66	24
NE	NW "	84	32		Sec. 22	640	
SE	" "	80			23	640	
	E½ "	320			24	640	
NE	NE 4	83	14		25	640	
SE	" "	80			26	640	
NE	NW "	86	61		27	640	
SE	" "	80			28	640	
	E½ "	320			29	640	
NE	NE 5	88	62	E½	30	320	
SE	" "	80		NW	"	99	60
NE	NW "	85	58	SW	"	99	92
SE	" "	80		E½	31	320	
	E½ "	320		NW	"	99	63
NE	NE 6	86	96	SW	"	98	23
SE	" "	80		Sec.	32	640	
	NW "	119	24		33	640	
	SE "	160			34	640	
	SW "	101	16		35	640	
	E½ 7	320			36	640	
	NW "	100	98			11,132	23
	SW "	102	18			1225	82
	Sec. 8	640		Deduct.		2330	84
	9	640					
	10	640					
	11	640					
	12	640					
	13	640					
	14	640					
	15	640					
	16	640					
	NE 17	320					
NE	SE "	97	60				
SE	" "	77	20				
NE	SW "	70	00				
SE	" "	60	30				
	E½ 18	320					
	NW "	102	22				
	SW "	101	22				
		1128	69				

2-10