


Township N. III south, Range N. XIV west Mer. (Mic. Tor.)

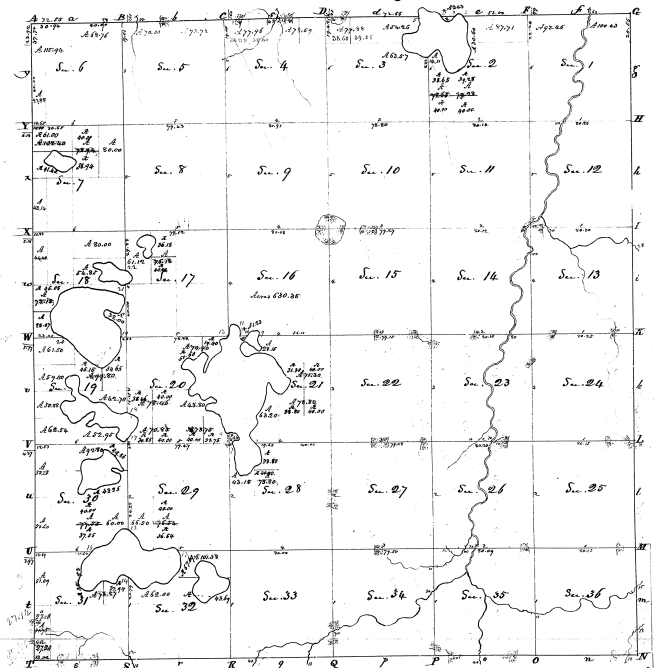

Surveyed in Dec. 1829 & Jan'y 1830 - by William Cookfield & S. S. Cook

Contract		Contract	
Acres	Value	Acres	Value
3/4 Sec 19	100.00	3/4 Sec 19	99.50
