



44

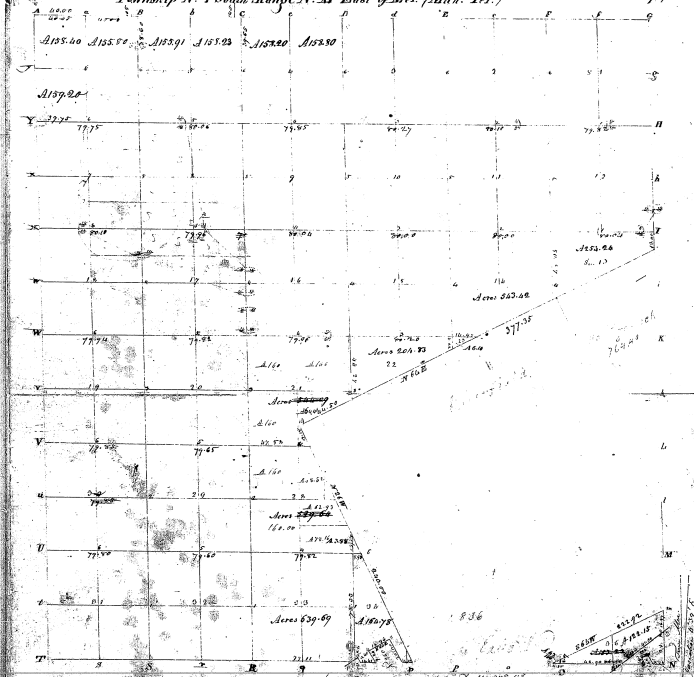

32-31

32-31

Remnants of section 11 and 12 of the original plat of 1817, 1818, 1819, 2000.