SURVEY & REMONUMENTATION

ACCEPTED BY THE BRANCH COUNTY SURVEY PEER GROUP AS THE OFFICIAL CORNER UNDER MICHIGAN PUBLIC ACT 345 OF 1990 AT A MEETING HELD ON 12-16-94

E. Reed C. Rep.

APR 26 1995
BRANCH COUNTY REMONUMENTATION CORNER
COMMISSION

LAND CORNER RECORDATION CERTIFICATE
Filing Requirement of Act 74, Mich. P.A. 1970

STATE OF MICHIGAN
Branch County
Recorded

12-28-1994 15:04:33

Linda Lee Morrison-Mathews
REGISTER OF DEEDS

Register of Deeds Stamp Page File Number 00002 0314

For corners in

Branch (County)

	Located In:	Corner Code #4
1. Public Land Survey	T 6 S R 6 W	C-4
	T ___ R ___	
	T ___ R ___	
	T ___ R ___	
2. Property Controlling	S ___ T ___ R ___	
in Section	S ___ T ___ R ___	
3. Miscellaneous	S ___ T ___ R ___	
Property in Sec.	S ___ T ___ R ___	

4. Lot No. _____ , Recorded Plat _____
5. Private Claims _____

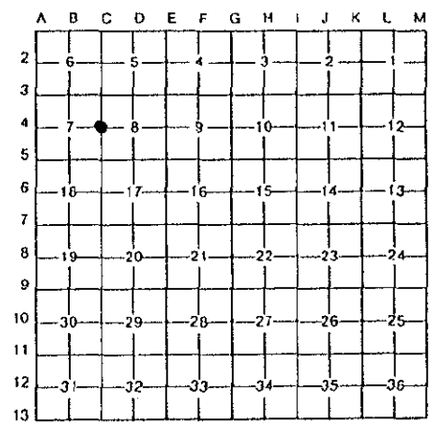

I, Edward W. Reed, in a field survey on September 22, 19 94, do hereby certify that under requirements of P.A. 74, Michigan P.A. of 1970, the corner points mentioned in lines 1 and 2 above were in conformance with regulations and rules therefore as required in the current manual of survey instructions of the United States Department of the Interior, Bureau of Land Management or by a decree of a Court of Law and/or that the corner points mentioned in lines 3, 4 and 5 above were in conformance with the rules of the Michigan Board of Land Surveyors or by a Decree of a Court of Law; established, re-established, monumented, re-monumented, recovered, found as expressed below:

NOTE: **Not more than 4 corners, all in the same town and range, may be recorded *on this certificate.***

A. Description of original monument and accessories and/or subsequent restoration:

Quarter corner common to Sections 7 and 8, Town 6 South, Range 6 West, Coldwater Township, Branch County, Michigan
1825: GLO notes, corner set
1856: Sprague, stone with bricks
1908: Hamilton, found stone with bricks
1980: E. R. Reed, found stone 18" deep and bricks. Placed iron rods over stone and set cast iron box, recorded II-24
1986: E. R. Reed, found iron over stone in cast iron box

B. Description of corner evidence found and/or method applied in restoring or reestablishing corner:

Found old iron rod in cast iron box agreeing with old witness
Replaced iron rod with 1/2" x 18" rebar iron and remonumentation cap
Raised monument box to road surface with (1) 1 1/2 and (1) 2 1/2 rings to bring flush with road surface

C. Description of monument for corner and accessories established to perpetuate locating the position of the corner:

1/2" rebar as noted above:
North 45 West 47.10-concrete post
South 58 West 41.58-face of concrete post
South 12 East 76.05-face of telephone pedestal
North 50 East 31.18-nail and washer North side of 36" tree
North 29 West 52.77-nail and washer North side of 30" hickory
(note cap and nail read #18994)

STATE OF MICHIGAN
EDWARD W. REED
LAND SURVEYOR
NO. 33985
LICENSED LAND SURVEYOR

And is accepted as a careful and faithful perpetuation of the position of the original corner.

Signed by Edward W. Reed
Edward W. Reed
Surveyor's Michigan License No. 33985

Date September 22, 1994

FORM APPROVED BY MICHIGAN STATE BOARD OF LAND SURVEYORS, JAN. 28, 1971
REVISED MAY 14, 1975
REVISED JAN., 1983