LAND CORNER RECORDATION CERTIFICATE
Filing Requirement of Act 74, Mich. P.A. 1970 as Amended

For corners in

Houghton
(County)

	Located In:			Corner Code #
1. Public Land Survey		T____	R____	
		T____	R____	
		T____	R____	
	S____	T____	R____	
2. Property Controlling	S 31	T 53N	R 35W	15
in Section	S____	T____	R____	
3. Miscellaneous	S____	T____	R____	
Property in Sec.	S____	T____	R____	

Register of Deeds Stamp & File Number

4. Lot No. _____ , Recorded Plat_____
5. Private Claims

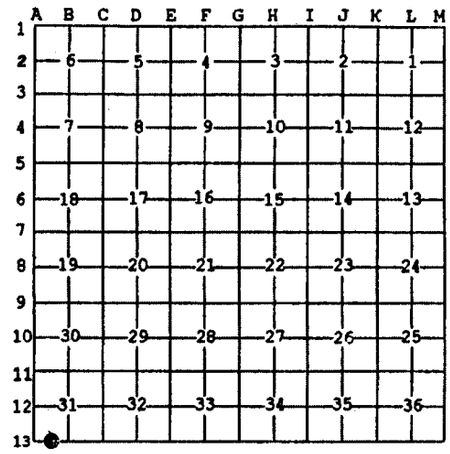

Jun 12 2007

I, Stephan J. Szyszkoski, in a field survey on _____, 20____ do hereby state that under requirements of P.A. 74, Michigan P.A. of 1970, the corner points mentioned in lines 1 and 2 above were in conformance with regulations and rules therefore as required in the current manual of survey instructions of the United States Department of the Interior, Bureau of Land Management or by a decree of a Court of Law and /or that the corner points mentioned in lines 3, 4 and 5 above were in conformance with the rules of the Michigan Board of Land Surveyors or by a Decree of a Court of Law; established, re-established, monumented, recovered, found as expressed below:

NOTE: Not more than 2 corners, all in the same town and range, may be recorded on this certificate.

A. Description of original monument and accessories and/or subsequent restoration:

(15-Sec. 31) West 1/16 on south side of Section 31. Not established in the original survey. The original GLO plat for T53N-R35W gives distances of 21.49 ch. west to the Township corner and 20.00 ch. east to the 1/4 corner on the South side of Sec. 31.

B. Description of corner evidence found and/or method applied in restoring or reestablishing corner:

(15-Sec. 31) Established the corner on the Township line 1420.99' east of the Township corner and 1322.47' west of the South 1/4 corner of Sec. 31, proportionate to the original GLO record.

C. Description of monument for corner and accessories established to perpetuate locating the position of the corner:

(15) Set 1"IDx32" I.pipe with 4" alum.
MDNR cap. Set measuring nails in:
7" B.Ash N37W 19.7' mrkd "1/16S BT"
6" Balsam S53W 4.3' do
5" B.Ash N80W 9.5' do
7" Balsam N40W 7.7' do
Distances are to nail with MDNR tag.
West 5.26' MDNR mon. at 1/16 corner for
Sec. 6 T52N-R35W

STATE OF MICHIGAN
STEPHAN J. SZYSZKOSKI
LAND SURVEYOR
No. 33986
LICENSED LAND SURVEYOR

Signed by Stephan J. Szyszkoski Date 7/12/07

Surveyor's Michigan License No. 33986

For the Michigan Department of Natural Resources, Office of Land and Facilities

FORM APPROVED BY MICHIGAN STATE BOARD OF PROFESSIONAL SURVEYORS, JAN. 28, 1971
Revised May 14, 1975
Revised Jan., 1983
Revised Oct., 1995