LAND CORNER RECORDATION CERTIFICATE

Filing Requirement of Act 74, Mich. P.A. 1970

For corners in
LAKE
(County)

		Located In:	Corner Code #1
1. Public Land Survey		T 19 N R 13 W	K-12
		T R	
		T R	
		T R	
2. Property Controlling	S 35	T R	2, 7
in Section	S	T R	
3. Miscellaneous	S 35	T R	# 656.1' S
Property in Sec.	S	T R	OF CODE #2.

Register of Deeds Stamp & File Number

4. Lot No. _____ , Recorded Plat _____
5. Private Claims

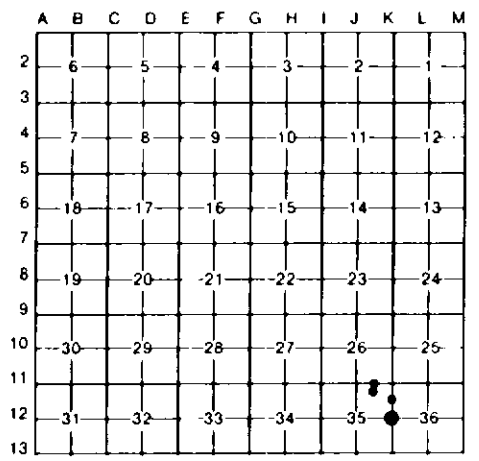

I, CARL F. ROSER, in a field survey on JUNE 6, 19 84, do hereby certify that under requirements of P.A. 74, Michigan P.A. of 1970, the corner points mentioned in lines 1 and 2 above were in conformance with regulations and rules therefore as required in the current manual of survey instructions of the United States Department of the Interior, Bureau of Land Management or by a decree of a Court of Law and/or that the corner points mentioned in lines 3, 4 and 5 above were in conformance with the rules of the Michigan Board of Land Surveyors or by a Decree of a Court of Law; established, re-established, monumented, re-monumented, recovered, found as expressed below.

NOTE: Not more than 4 corners, all in the same town and range, may be recorded on this certificate.

A. Description of original monument and accessories and/or subsequent restoration:

K-12	2	7	#

B. Description of corner evidence found and/or method applied in restoring or reestablishing corner:

K-12	2	7	#
COR. IS PREVIOUS DEPT. COR OF RECORD, CFR 1972; COR WAS ESTABILISHED PER STD BLM INSTRUCTIONS.	ESTABILISH NE COR, N 1/2, NW 1/4, NE 1/4, SEC 35 PER STD BLM INSTRUCTIONS. Cor. falls in approx. line of barb wire s/y, in Trees.	FD 1" PIPE FOR NE COR OF SE 1/4-NE 1/4 OF SEC 35. COR IS PREVIOUS DEPT. COR OF RECORD, CFR 1972. COR WAS ESTABILISHED PER STD BLM INSTRUCTIONS, 1972. COR IS BURIED 8" IN APPOX CTR N-S DIRT RD.	ESTABILISH NE COR, S 1/2, NW 1/4, NE 1/4, SEC. 35 PER STD BLM INSTRUCTIONS.

C. Description of monument for corner and accessories established to perpetuate locating the position of the corner:

K-12			2			7			#		
D.N.R. MON. AND CED POST			DROVE 5/8"X 34" RE-ROD W/RLS			FD 1" PIPE			DROVE 5/8"X 34" RE-ROD W/RLS		
8" B OAK	N 57°E	19.9'	CAP			14" W OAK	S 55°W	28.0'	CAP, SET CED POST W/LOC TAG		
12" B OAK	N 40°W	20.5'	11" B OAK	N 40°W	17.69'	19" B OAK	S 45°E	30.4'	12' B OAK	N 35°E	8.8'
4" R OAK	S 60°W	5.6'	12" B OAK	N 05°W	36.17'	SET CED POST			9" B OAK	S 20°W	7.4'
5" W OAK	S 20°E	20.1'	10" B OAK	N 35°E	21.10'	W/LOC TAG	DUE W	33'	6" W OAK	S 50°W	15.1'
WINDING N-S			CTR E-W RD	DUE S	5'						
ROAD	DUE E	115'± 2'	SET CED POST								
			W/ LOC TAG	DUE S	33'						

Signed by Carl F. Roser 3-18-88 Date

Surveyor's Michigan License No. 12028

STATE OF MICHIGAN
CARL F. ROSER
LAND SURVEYOR
No. 12028
REGISTERED LAND SURVEYOR

FORM APPROVED BY MICHIGAN STATE BOARD OF LAND SURVEYORS, JAN. 29, 1997
REVISED JULY 14, 1975
REVISED JAN. 1, 1983