

FEB 25 1999

FILED

9-

SECTION

LAND CORNER RECORDATION CERTIFICATE

Filing Requirement of Act 74, Mich. P.A. 1970 1998 OCT 27 P 2: 22

For corners in

Livingston
(County)

Located In:

Corner Code //

NANCY HAVILAND
REGISTER OF DEEDS
LIVINGSTON COUNTY, MI.
48843

LSC970M

Register of Deeds Stamp & File Number

- 1. Public Land Survey T 1N R 6E T-8
 T _____ R _____
 T _____ R _____
 T _____ R _____
- 2. Property Controlling S _____ T _____ R _____
 in Section S _____ T _____ R _____
- 3. Miscellaneous S _____ T _____ R _____
 Property in Sec. S _____ T _____ R _____
- 4. Lot No. _____, Recorded Plat _____
- 5. Private Claims _____

	A	B	C	D	E	F	G	H	I	J	K	L	M
2	6	5	4	3	2	1							
3													
4	7	8	9	10	11	12							
5													
6	18	17	16	15	14	13							
7													
8	19	20	21	22	23	24							
9													
10	30	29	28	27	26	25							
11													
12	31	32	33	34	35	36							
13													

I, Bryan L. Boss, in a field survey on September 30, 19 98, do hereby certify that under requirements of P.A. 74, Michigan P.A. of 1970, the corner points mentioned in lines 1 and 2 above were in conformance with regulations and rules therefore as required in the current manual of survey instructions of the United States Department of the Interior, Bureau of Land Management or by a decree of a Court of Law and/or that the corner points mentioned in lines 3, 4 and 5 above were in conformance with the rules of the Michigan Board of Land Surveyors or by a Decree of a Court of Law; established, re-established, monumented, re-monumented, recovered, found as expressed below:

NOTE: Not more than 4 corners, all in the same town and range, may be recorded on this certificate.

A. Description of original monument and accessories and/or subsequent restoration:

Set 1/2 mile post in marsh
White Oak 12" N 54 1/2 E 2.24


B. Description of corner evidence found and/or method applied in restoring or reestablishing corner:

Found 1/2" iron rod 5' South of Doane Road

PA. 345 1990, APPROVED BY LIVINGSTON COUNTY
PEER GROUP ON 9-16-98 CO. REP JED

C. Description of monument for corner and accessories established to perpetuate locating the position of the corner:

Set 30" by 1 1/4" pipe with 1 1/4 by 6" pipe and breakaway Stamped
"Livingston County Monumentation Corner"
N 33 W 47.05 N/T East side powerpole
N 40 E 62.72 N/T top of post at East end of Northerly rail on Doane Rd.
S 25 W 54.36 N/T Northwest side power pole
S 03 E 34.92 N/T Westside 18" Ash

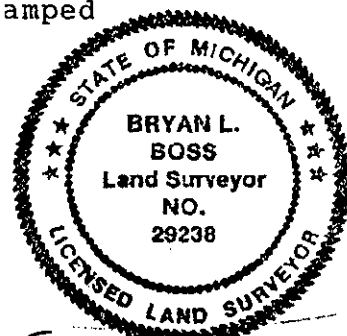

Signed by Bryan L. Boss Date 10-15-1998
Surveyor's Michigan License No. 29238