SURVEY & REMONUMENTATION

FEB 25 1999

SECTION

9-

FILED

1998 OCT 27 P 2:22

NANCY HAVILAND
REGISTER OF DEEDS
LIVINGSTON COUNTY, MI.
48843

LSC974M

Register of Deeds Stamp & File Number

LAND CORNER RECORDATION CERTIFICATE

Filing Requirement of Act 74, Mich. P.A. 1970

For corners in Livingston (County)

	Located In:	Corner Code //
1. Public Land Survey	T 1N R 6E	K-6
	T ___ R ___	
	T ___ R ___	
	T ___ R ___	
2. Property Controlling	S ___ T ___ R ___	
in Section	S ___ T ___ R ___	
3. Miscellaneous	S ___ T ___ R ___	
Property in Sec.	S ___ T ___ R ___	

4. Lot No. _____, Recorded Plat _____
5. Private Claims _____

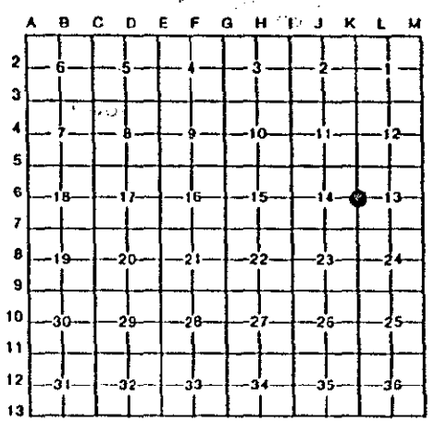

I, Bryan L. Boss, in a field survey on September 30, 19 98, do hereby certify that under requirements of P.A. 74, Michigan P.A. of 1970, the corner points mentioned in lines 1 and 2 above were in conformance with regulations and rules therefore as required in the current manual of survey instructions of the United States Department of the Interior, Bureau of Land Management or by a decree of a Court of Law and/or that the corner points mentioned in lines 3, 4 and 5 above were in conformance with the rules of the Michigan Board of Land Surveyors or by a Decree of a Court of Law; established, re-established, monumented, re-monumented, recovered, found as expressed below:

NOTE: **Not more than 4 corners, all in the same town and range, may be recorded on this certificate.**

A. Description of original monument and accessories and/or subsequent restoration:

White Oak 12" S 16½ E 58 links
White Oak 30" N 20 W 66 links

B. Description of corner evidence found and/or method applied in restoring or reestablishing corner:

Found 3/4" pipe 1.5' South of centerline 12 Mile road and 1.5 East of centerline Peer Road

P.A. 345 1990, APPROVED BY LIVINGSTON COUNTY
PEER GROUP ON 9-30-98, CO. REP JED

C. Description of monument for corner and accessories established to perpetuate locating the position of the corner:

Set 30" by 1¼" pipe with 6" breakaway and Brass cap stamped "Livingston County Remonumentation"
N 50 E 50.32 set REmon N/T Northwest side 12" Pine
S 13 E 72.20 set Remon N/T West side 28" Poplar
S 37 W 70.00 set Remon N/T Northwest side power pole
N 72 W 91.08 set Remon N/T Southwest side power pole
(N/NW 12.25' Fd. ½" I. Rod)

STATE OF MICHIGAN
BRYAN L. BOSS
Land Surveyor
NO. 29238
LICENSED LAND SURVEYOR

Signed by Bryan L. Boss Date 10-16-1998

Surveyor's Michigan License No. 29238

FORM APPROVED BY MICHIGAN STATE BOARD OF LAND SURVEYORS, JAN. 28, 1972
REVISED MAY 14, 1975
REVISED JAN., 1983