

OCT 3 2000

SECTION

LAND CORNER RECORDATION CERTIFICATE
Filing Requirement of Act 74, Mich. P.A. 1970

For corners in

Manistee (County) Located In: Corner Code #
1. Public Land Survey T 24N R 15W I-13
T R SE Sec Corner
T R Sec 34
2. Property Controlling S T R
in Section S T R
3. Miscellaneous S T R
Property in Sec. S T R
4. Lot No. , Recorded Plat
5. Private Claims

REGISTER'S OFFICE
MANISTEE COUNTY
00-285 AT 10:42 p.m.
SEP 03 2000
Perry A. Repas
REGISTER OF DEEDS

Register of Deeds Stamp & File Number

I, Anthony M. Slawinski, in a field survey on June 29, 20 00 do hereby state that under requirements of P.A. 74, Michigan P.A. of 1970, the corner points mentioned in lines 1 and 2 above were in conformance with regulations and rules therefore as required in the current manual of survey instructions of the United States Department of the Interior, Bureau of Land Management or by a decree of a Court of Law and /or that the corner points mentioned in lines 3, 4 and 5 above were in conformance with the rules of the Michigan Board of Land Surveyors or by a Decree of a Court of Law; established, re-established, monumented, recovered, found as expressed below:

Grid table with columns A-M and rows 1-13. Cell (2,6) contains '6', (2,5) contains '5', (2,4) contains '4', (2,3) contains '3', (2,2) contains '2', (2,1) contains '1'. Cell (4,7) contains '7', (4,8) contains '8', (4,9) contains '9', (4,10) contains '10', (4,11) contains '11', (4,12) contains '12'. Cell (6,1) contains '18', (6,2) contains '17', (6,3) contains '16', (6,4) contains '15', (6,5) contains '14', (6,6) contains '13'. Cell (8,1) contains '19', (8,2) contains '20', (8,3) contains '21', (8,4) contains '22', (8,5) contains '23', (8,6) contains '24'. Cell (10,1) contains '30', (10,2) contains '29', (10,3) contains '28', (10,4) contains '27', (10,5) contains '26', (10,6) contains '25'. Cell (12,1) contains '31', (12,2) contains '32', (12,3) contains '33', (12,4) contains '34', (12,5) contains '35', (12,6) contains '36'.

NOTE: Not more than 2 corners, all in the same town and range, may be recorded on this certificate.

A. Description of original monument and accessories and/or subsequent restoration: Southeast Corner of Section 34 (24-15) Set by John Brink in 1838.

- 1. Black Ash 22" in dia. N 4° E 50 links (33.00')
2. Hemlock 14" in dia. N 22 1/2° W 45 links (29.70')
Closing corner for (23-15) was set by Brink 125 links (82.50') East of Southeast corner of Section 34 (24-15)

Manistee County Surveyor's Record Book A, Page 296
One stake set by J.H. Millard in 1907, one witness:
3. Cedar 4" in dia. N 18° E 74 1/2 links (49.17')

Witnesses from Manistee County Road Commission
Fd. plow point 1999
4. S 51° E 63.52' Power Pole
5. S 02° E 44.14' 14" Box Elder
6. N 66° W 103.30' 18" Maple

B. Description of corner evidence found and/or method applied in restoring or reestablishing corner: Southeast Corner of Section 34 (24-15)
On June 29, 2000, I Anthony M. Slawinski, along with a field crew from Abonmarche, re-set the corner using the witnesses from Manistee County Road Commission. That part of 13 Mile Road was re-constructed during 1999 and the corner was not re-set. We found no other evidence that would dispute this location for the corner.


Condition of witnesses: #1 gone, #2 gone, #3 gone, #4 good, #5 good, & #6 good

C. Description of monument for corner and accessories established to perpetuate locating the position of the corner: Southeast Corner of Section 34 (24-15)
On June 29, 2000, I set a Manistee County Monument, within a monument box, at the position established from the Witnesses in Part B as a careful and faithful re-establishment of the position of the original corner, and witnessed by:

- 4. S 51° E 63.52' Power Pole (fd. 60d spike in SW side of pole)
5. S 02° E 44.14' 14" Box Elder (fd. 60d spike in E. side of tree)
6. N 66° W 103.30' 18" Maple (fd. 60d spike in NE side of tree)
7. S 43° W 56.04' 6" Red Pine (set 40d spike in N side of tree)

Corner is in the centerline of 13 Mile Road 85.56' west of the closing corner for T23N, R15W. The Corner is 85' west of the centerline, intersection of 13 Mile Road and Chief Road.

ratified by the Manistee County Peer Group according to the county plan adopted pursuant to P.A. 345 of 1990, as amended, (being the State Survey and Monument Act, MCL 54.251 et seq.). Date of Peer Review: 7-31-00
Anthony M. Slawinski

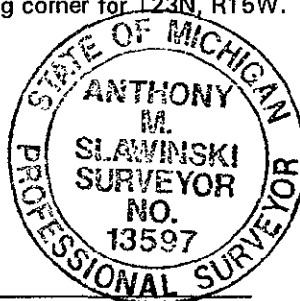

Signed by Anthony M. Slawinski
Surveyor's Michigan License No. 13597

Date 7-26-00