SURVEY &
REMONUMENTATION

MAR 29 2000

SECTION TOWNSHIP 38 NORTH - RANGE 28 WEST

● - INDICATES CORNER TO BE MONUMENTED IN 1999 PROJECT YEAR - 4 CORNERS
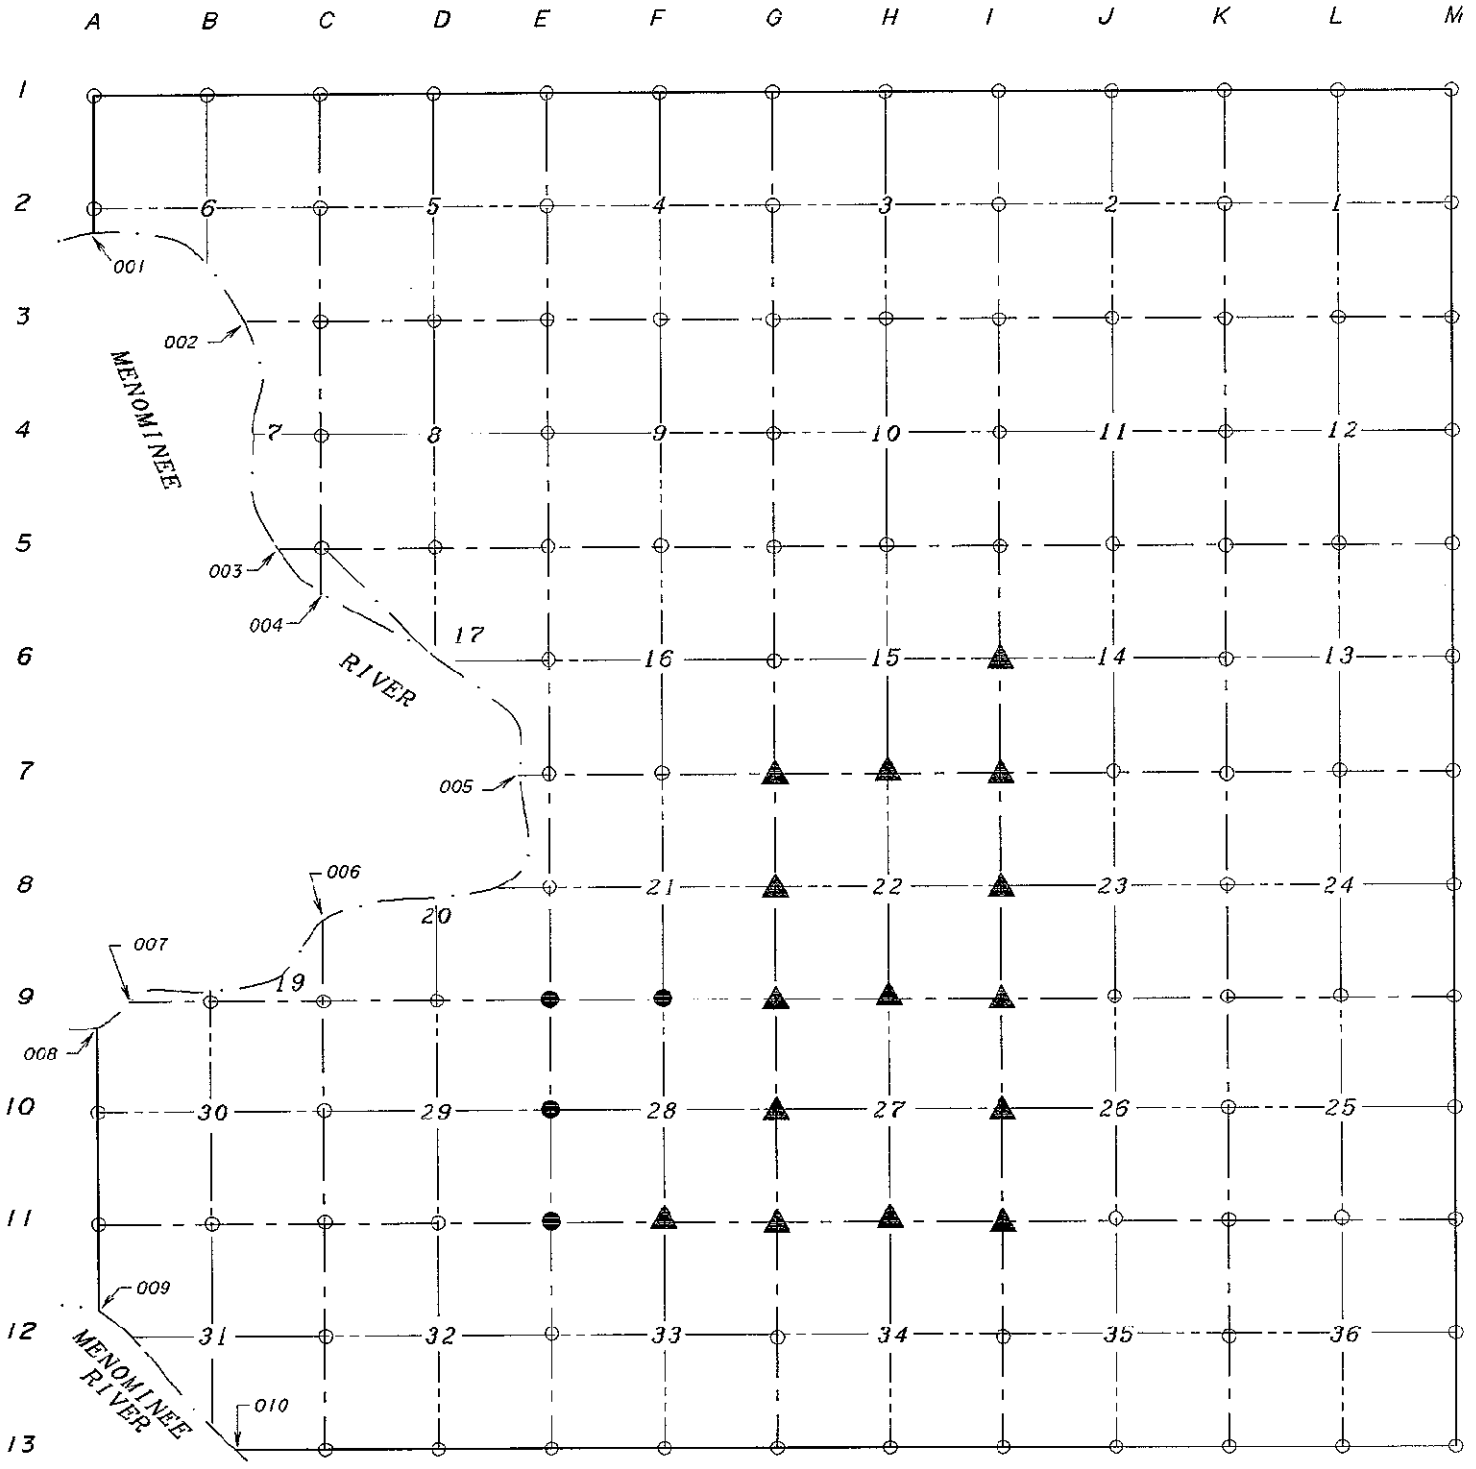
▲ - INDICATES CORNER MONUMENTED IN PREVIOUS PROJECT YEAR - (15)