LAND CORNER RECORDATION CERTIFICATE

Filing Requirement of Act 74, Mich. P.A. 1970

For corners in MISSAUKEE (County)

	Located In:	Corner Code ##
1. Public Land Survey	T 21N R 5W	6-9, 6-10,
	T ___ R ___	I-10
	T ___ R ___	
	T ___ R ___	
2. Property Controlling	S 27 T ___ R ___	10
in Section	S ___ T ___ R ___	
3. Miscellaneous	S ___ T ___ R ___	
Property in Sec.	S ___ T ___ R ___	

Register of Deeds Stamp & File Number

4. Lot No. _____ , Recorded Plat _____
5. Private Claims _____

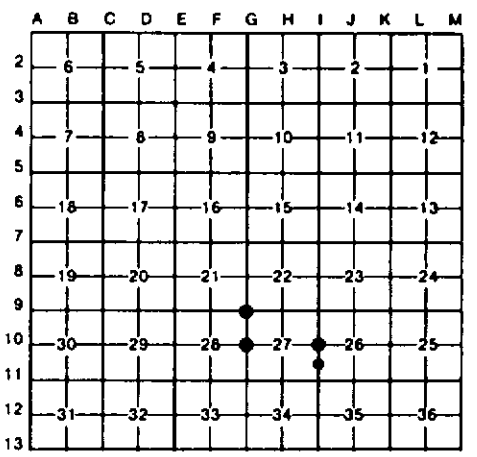

I, CARL F. ROSER, in a field survey on NOVEMBER 8, 19 89, do hereby certify that under requirements of P.A. 74, Michigan P.A. of 1970, the corner points mentioned in lines 1 and 2 above were in conformance with regulations and rules therefore as required in the current manual of survey instructions of the United States Department of the Interior, Bureau of Land Management or by a decree of a Court of Law and/or that the corner points mentioned in lines 3, 4 and 5 above were in conformance with the rules of the Michigan Board of Land Surveyors or by a Decree of a Court of Law; established, re-established, monumented, re-monumented, recovered, found as expressed below:

NOTE: Not more than 4 corners, all in the same town and range, may be recorded on this certificate.

A. ~~Description of original monument and accessories and/or subsequent restoration:~~

6-9

6-10

I-10

10

"B" CONTINED:
COR FALLS 3' SOUTH OF CTR E-W TRAIL IN CUT AREA (M. SCHAAF NOTES SAY "COR FALLS IN S. EDGE OF CUT").

B. Description of corner evidence found and/or method applied in restoring or reestablishing corner:

6-9
FD DEPT MON (1" PIPE W/BRASS CAP INSIDE M.SCHAAF 1 1/2" PIPE) FOR NE COR SEC. 28. K. OSTLING, DEPT. L.S., SET MON IN 1950 SUR AT FD M.SCHAAF PIPE. SCHAAF FD USBT (W.P. STP) NE, USBT (W.P STP HOLE)SW AND LINE TREE EVIDENCE E & N, IN 1938 SURVEY.

6-10
ESTABLISHED E 1/4 COR OF SEC 28 MIDWAY & ON LINE BETWEEN FD SECTION CORS 1/2 MILE N & S. COR IS 21'± N OF CTR E-W SAND TRAIL & 25'± 3' WEST OF CTR OF OLD TWP RD GRADE LOOKING TO SOUTH.

I-10
RESET E 1/4 COR SEC 27 FROM ONE FD M.SCHAAF STP (PINE STP S18°E, 36.3' - WE MEAS S14°E, 36.3') AND ONE PINE STP M. SCHAAF CALLED GLO WIT (Y.PINE 14, S40°E, 26.40 GLO- WE MEAS TO PINE STP REMAINS W/LOWER NOTCH S35°E, 26.6'). THIS ALSO FITS FD PINE ROOTS FROM M. SCHAAF WIT TO NW.

(CONTINUED UNDER "A")

10
ESTABLISHED NW COR OF S 1/2 OF SW 1/4 OF SEC 27 PER STANDARD BLM INSTRUCITONS. CTR OF OLD N-S TWP RD GRADE IS 10' EAST.

C. Description of monument for corner and accessories established to perpetuate locating the position of the corner:

6-9
FD CONSERVATION DEPT MON; SET CED POST.

*19" R PINE	N15°W	95.0'
* 8" W BIRCH	N85°E	6.4'
6" MAPLE	S20°E	8.7'
10" R OAK	S50°W	15.4'

6-10
SET DNR MON & CED POST.

24" B OAK	N65°W	49.3'
6" B CHERRY	N30°W	43.8'
7" B CHERRY IN CLUMP 2	N 5°E	54.5'
23" B OAK (CLP 3)	N85°E	36.9'

I-10
SET DNR MON & CED POST.

15" OAK (CLP 2)	N55°W	43.3'
6" MAPLE (CLP 7)	N 5°E	34.5'
11" R OAK	DUE S	33.4'
15" R OAK	S35°W	34.8'

10
DROVE 5/8" X 34" REROD W/RLS CAP & SET CED POST W/LOC TAG.

7" B CHERRY	N25°W	20.1'
13" W OAK	N65°E	58.2'
8" R PINE	S50°E	70.4'
3" B OAK	S30°W	22.1'

*= RLS K. OSTLING WIT.

Signed by Carl F. Roser 12028 Date 5-22-92

Surveyor's Michigan License No. _____

STATE OF MICHIGAN
CARL F. ROSER
LAND SURVEYOR
No. 12028
REGISTERED LAND SURVEYOR

FORM APPROVED BY MICHIGAN STATE BOARD OF LAND SURVEYORS, JAN. 26, 1971
REVISED MAY 14, 1975
REVISED JAN., 1983