

1993
LAND CORNER RECORDATION CERTIFICATE
COMMISSION FILING REQUIREMENT OF ACT 74, MICH. P.A. 1970

FOR CORNERS OF --:	LOCATED IN --:	CORNER CODE NUMBER
1. PUBLIC LAND SURVEY _____ T. <u>12</u> N. S., R. <u>4</u> E. W.		A-12
2. PROPERTY CONTROLLING IN SECTION _____, T. _____ N. S., R. _____ E. W.		
3. MISCELLANEOUS PROPERTY IN SECTION _____, T. _____ N. S., R. _____ E. W.		
4. LOT NO. _____, RECORDED PLAT _____		
5. PRIVATE CLAIMS _____		

RECORDED & FILED
Sheet 6 Page 172
DEC 22 2 12 PM '93
MICHIGAN STATE BOARD OF REGISTRATION
REGISTER OF DEEDS
SAGINAW COUNTY MICH.
REGISTER OF DEEDS STAMP AND FILING NUMBER

I, Duane F. Ledy, do hereby certify that under requirements of P.A. 74, Michigan P.A. of 1970, the corner points mentioned in lines 1 and 2 above were, in a field survey on September, 1993, established, re-established, monumented, re-monumented, recovered or restored as expressed below and in conformance with regulations and rules therefore as required in the current manual of survey instructions of the United States Department of the Interior, Bureau of Land Management or by a decree of a court of law. Furthermore, that the corner points mentioned in lines 3, 4 and 5 above were, in a field survey on September, 1993, found, recovered, restored, established or re-established as expressed below and in conformance with the rules of the Michigan State Board of Registration for Land Surveyors or, by a Decree of a Court of law:

A. Description of original monument and accessories and/or subsequent restoration:
Corner A-12 not originally established by GLO survey. No records available of the establishment of existing monumentation at A-12.

B. Description of corner evidence found and/or method applied in restoring or re-establishing corner:
Found R.R. spike at intersection 12.31 feet North of a P.K. nail and 0.44 feet East of line between P.K. nail and A-11. P.K. nail is corner accepted for M-12 by useage. GLO established M-12 at 40 chains and M-11 at 80 chains from M-13. A-11 closed on Standard line at 5 links South of M-11. Proportional distance would place A-12 at 2.5 links South of M-12 (1.65'). Saginaw County Road Commission witnesses and surveys in area confirm useage of R.R. spike as corner of record (A-12) at 12.31 feet North of M-12. Corner as occupied accepted by Saginaw County Remonumentation Peer Group review on October 7, 1993.

C. Description of monument for corner and accessories established to perpetuate locating the position of the corner:
Set 5/8" Rod & Sag. Co. Remon. 3" brass cap in monument box.

S 45 W	48.91	Nail & brass tag marked "P.S. 21575" in N. side power pole
N 35 W	62.33	Nail & brass tag marked "P.S. 21575" in E. side power pole
N 45 E	51.44	Nail & brass tag marked "P.S. 21575" in S. side power pole
S 45 E	57.43	Nail & brass tag marked "P.S. 21575" in N. side power pole
South	12.31	P.K. Nail; corner M-12, T12N, R3E
West	0.44	To Standard line


SIGNED BY Duane F. Ledy DATE Dec 22, 1993

SURVEYOR'S MICHIGAN REGISTRATION NO. 21575

FOR STATE AND UNITED STATES AGENCIES:

SIGNED BY _____ DATE _____
CHIEF OF SURVEY PARTY

APPROVED AND SIGNED BY _____ DATE _____
MICHIGAN REGISTERED LAND SURVEYOR

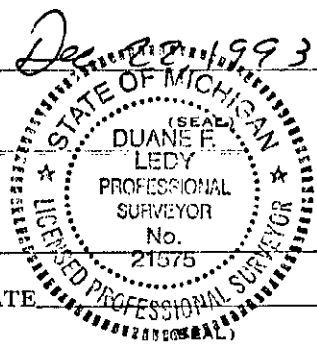

SURVEYOR'S MICHIGAN REGISTRATION NO. _____