LAND CORNER RECORDATION CERTIFICATE

Filing Requirement of Act 74, Mich. P.A. 1970 as Amended

For corners in

Baraga (County) Located In: Corner Code #

1. Public Land Survey		T	R			
		T	R			
		T	R			
2. Property Controlling	S 14	T 48N	R 32W		12	
in Section	S 14	T 48N	R 32W		5	
	S	T	R			
3. Miscellaneous	S	T	R			
Property in Sec.	S	T	R			

4. Lot No. _____, Recorded Plat _____

5. Private Claims

Register of Deeds Stamp & File Number

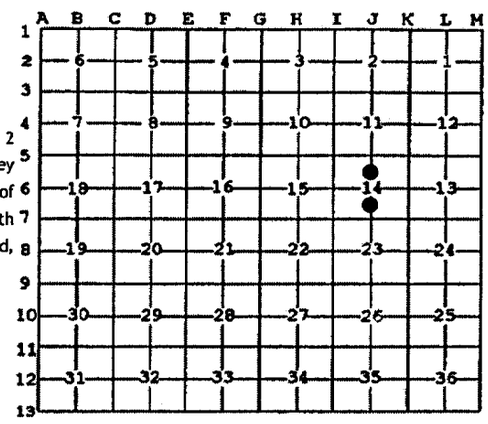

I, Stephan J. Szyszkoski, in a field survey on 12 06/01/2010 5 06/01/2010 do hereby state that under requirements of P.A. 74, Michigan P.A. of 1970, the corner points mentioned in lines 1 and 2 above were in conformance with regulations and rules therefore as required in the current manual of survey instructions of the United States Department of the Interior, Bureau of Land Management or by a decree of a Court of Law and /or that the corner points mentioned in lines 3, 4 and 5 above were in conformance with the rules of the Michigan Board of Land Surveyors or by a Decree of a Court of Law; established, re-established, monumented, recovered, found as expressed below:

NOTE: Not more than 2 corners, all in the same town and range, may be recorded on this certificate.

A. Description of original monument and accessories and/or subsequent restoration:

(12-Sec. 14) South 1/16 corner, Section 14. Not established in the original survey.

(5-Sec. 14) North 1/16 corner, Section 14. Not established in the original survey.

B. Description of corner evidence found and/or method applied in restoring or reestablishing corner:

(12-Sec. 14) Established the corner midway and on a straight line between Center of Section 1312.71' north and Quarter corner 1312.71' south.

(5-Sec. 14) Established the corner midway and on a straight line between Quarter corner 1314.79' north and Center of Section 1314.79' south.

C. Description of monument for corner and accessories established to perpetuate locating the position of the corner:

(12) Set 1"IDx32" I.pipe with 4" alum. MDNR cap.
Set measuring nail with MDNR tag in the side of:
8" Cedar N13W 8.0' mrkd "1/16S BT"
9" W.Pine N52E 23.1' do
9" Cedar S28W 21.4' do
8" Spruce N86W 13.95' do
Sq'd cedar post adjacent. Bearings magnetic.

(5) Set 1"IDx32" I.pipe with 4" alum. MDNR cap.
Set measuring nail with MDNR tag in the side of:
8" Balsam N37E 5.15' mrkd "1/16S BT"
14" Spruce N59E 23.4' do
6" Balsam S15W 18.75' do
12" Maple in clump S66W 11.3' do
Sq'd cedar post adjacent. Bearings magnetic.

Signed by Stephan J. Szyszkoski Date 08/16/2010

Surveyor's Michigan License No. 33986

STATE OF MICHIGAN STEPHAN J. SZYSZKOSKI LAND SURVEYOR No. 33986 LICENSED LAND SURVEYOR

For the Michigan Department of Natural Resources and Environment, Forest Management Division

16474

16475

FORM APPROVED BY MICHIGAN STATE BOARD OF PROFESSIONAL SURVEYORS Jan., 1971
Revised Feb. 14, 1975
Revised Jan., 1983
Revised Oct., 1995