SURVEY & REMONUMENTATION

1993

COMMISSION

RECORDED

REMONUMENTATION

LAND CORNER RECORDATION CERTIFICATE

Filing Requirement of Act 74, Mich. P.A. 1970

OCT 6 9 47 AM '93

CLERK-REGISTER
CALHOUN COUNTY, MICH.
ANNE B. NORLANDER

For corners in CALHOUN (County)

	Located In:	Corner Code ##
1. Public Land Survey	T 1 S R 5 W	A-12
	T ___ R ___	
	T ___ R ___	
	T ___ R ___	
2. Property Controlling	S ___ T ___ R ___	
in Section	S ___ T ___ R ___	
3. Miscellaneous	S ___ T ___ R ___	
Property in Sec.	S ___ T ___ R ___	

Register of Deeds Stamp & File Number

4. Lot No. _____ , Recorded Plat _____
5. Private Claims _____

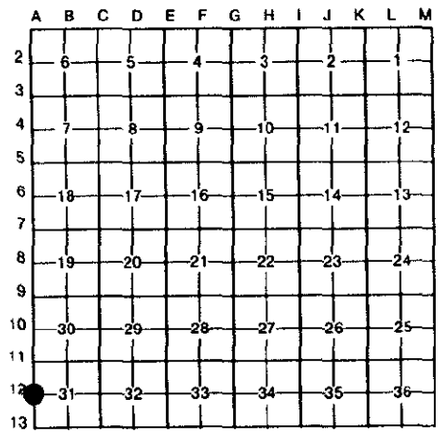

I, DONALD J. DAVIS, in a field survey on SEPTEMBER 8, 19 93, do hereby certify that under requirements of P.A. 74, Michigan P.A. of 1970, the corner points mentioned in lines 1 and 2 above were in conformance with regulations and rules therefore as required in the current manual of survey instructions of the United States Department of the Interior, Bureau of Land Management or by a decree of a Court of Law and/or that the corner points mentioned in lines 3, 4 and 5 above were in conformance with the rules of the Michigan Board of Land Surveyors or by a Decree of a Court of Law; established, re-established, monumented, re-monumented, recovered, found as expressed below:

NOTE: Not more than 4 corners, all in the same town and range, may be recorded on this certificate.

A. Description of original monument and accessories and/or subsequent restoration:

CORNER NOT SET IN ORIGINAL OR RESURVEY. EAST ¼ CORNER OF SECTION 36, T1S, R6W, ESTABLISHED AND THIS CORNER SET AT GOVERNMENT DISTANCE.
CORNER HAS BEEN USED BY SURVEYORS IN THIS AREA.

LIBER 1707 PAGE 272

B. Description of corner evidence found and/or method applied in restoring or reestablishing corner:

FOUND 3/4" PIPE 18" LONG WITH ROCKS AROUND.
30" HICKORY S 65° E 25.60'.
CONCRETE MONUMENT N 65° W 34.58' (WITNESSES FROM 1976).
6" CHERRY N 40° W 48.20'.
10.56' SOUTH OF 5/8" IRON MARKING CONVIS CORNER.

CORNER ACCEPTED AS TRUE CORNER REESTABLISHED FROM GOVERNMENT NOTES.

C. Description of monument for corner and accessories established to perpetuate locating the position of the corner:

SET HARRISON MONUMENT 6" UNDER GRAVEL.
NAIL & TAG 30" HICKORY S 65° E 26.45'.
NAIL & TAG 8" CHERRY N 45° W 48.25'.
NAIL & TAG 8" HICKORY EAST 34.58'.
CONCRETE MONUMENT N 65° W 34.58'.
10.56' SOUTH OF CONVIS CORNER.
6' EAST OF CENTERLINE GRAVEL.

STATE OF MICHIGAN
DONALD J. DAVIS
PROFESSIONAL SURVEYOR
No. 17617
LICENSED PROFESSIONAL SURVEYOR

Signed by Donald J. Davis Date SEPTEMBER 14, 1993.

Surveyor's Michigan License No. 17617

FORM APPROVED BY MICHIGAN STATE BOARD OF LAND SURVEYORS, JAN. 28, 1971
REVISED MAY 14, 1975