LAND CORNER RECORDATION CERTIFICATE
Filing Requirement of Act 74, Mich. P.A. 1970 as Amended

For corners in

Chippewa
(County)

		Located In:		Corner Code #
1. Public Land Survey		T____	R____	
		T____	R____	
		T____	R____	
	S____	T____	R____	
2. Property Controlling	S 9	T 49N	R 6W	12
in Section	S 9	T 49N	R 6W	13
3. Miscellaneous	S____	T____	R____	
Property in Sec.	S____	T____	R____	

Register of Deeds Stamp & File Number

4. Lot No. _____ , Recorded Plat_____
5. Private Claims

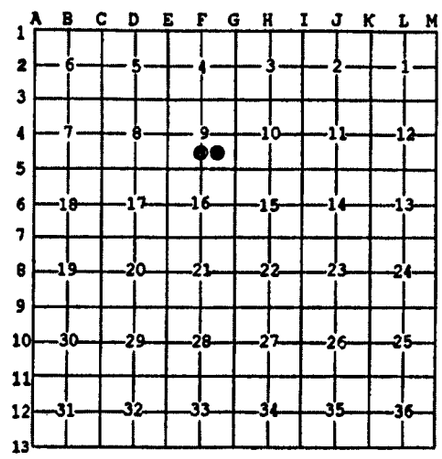

I, Stephan J. Szyszkoski, in a field survey on Apr 26 2006, 20 ____ do hereby state that under requirements of P.A. 74, Michigan P.A. of 1970, the corner points mentioned in lines 1 and 2 above were in conformance with regulations and rules therefore as required in the current manual of survey instructions of the United States Department of the Interior, Bureau of Land Management or by a decree of a Court of Law and /or that the corner points mentioned in lines 3, 4 and 5 above were in conformance with the rules of the Michigan Board of Land Surveyors or by a Decree of a Court of Law; established, re-established, monumented, recovered, found as expressed below:

NOTE: Not more than 2 corners, all in the same town and range, may be recorded on this certificate.

A. Description of original monument and accessories and/or subsequent restoration:

(12-Sec. 9) South 1/16 corner, Section 9. Not established in the original survey. Found no subsequent record.
(13-Sec. 9) Southeast 1/16 corner, Sec. 9. Not established in the original survey. Found no subsequent record.

B. Description of corner evidence found and/or method applied in restoring or reestablishing corner:

(12-Sec. 9) Established the corner midway and on a straight line between the South 1/4 corner of Section 9, 1326.47' south, and the intersection of quarter lines 1326.47' north. Corner lies approximately 20 ' south of an E-W trail.
(13-Sec. 9) Established the corner at the intersection of straight lines connecting opposite 1/16 corners.

C. Description of monument for corner and accessories established to perpetuate locating the position of the corner:

(12) Set 1"IDx36" I.pipe with 4" alum. MDNR cap. Set measuring nails in:
5" J.Pine N88W 7.6' mrkd "S1/16 BT"
10" J.Pine S34E 13.65' do
6" Oak N82E 27.35' do
6" J.Pine N36E 12.03' do
Bearings are magnetic. Distances are to nail with tag.

(13) Set 1"IDx36" I.pipe with 4" alum. MDNR cap. Set measuring nails in:
5" J.Pine N67W 25.85' mrkd "SE1/16 BT"
5" J.Pine N06E 14.6' do
6" J.Pine N81E 16.4' do
4" J.Pine S25E 9.23' do
Bearings are magnetic. Distances are to nail with tag.

STATE OF MICHIGAN
STEPHAN J. SZYSZKOSKI
LAND SURVEYOR
No. 33986
LICENSED LAND SURVEYOR

Signed by Stephan J. Szyszkoski Date 8/3/06

Surveyor's Michigan License No. 33986

For the Michigan Department of Natural Resources, Office of Land and Facilities

FORM APPROVED BY MICHIGAN STATE BOARD OF PROFESSIONAL SURVEYORS, JAN. 28, 1971
Revised May 14, 1975
Revised Jan., 1983
Revised Oct., 1995