STATE OF MICHIGAN
CRAWFORD COUNTY
RECORDED
31 DEC 96 9:32 A.M.
SANDRA MOORE
REGISTER OF DEEDS

LAND CORNER RECORDATION CERTIFICATE

Filing Requirement of Act 74, Mich. P.A. 1970

For corners in Crawford (County)

	Located In:	Corner Code #
1. Public Land Survey	T 25N R 2W	M - 13
	T 25N R 1W	A - 13
	T ___ R ___	
	T ___ R ___	
2. Property Controlling	S ___ T ___ R ___	
in Section	S ___ T ___ R ___	
3. Miscellaneous	S ___ T ___ R ___	
Property in Section	S ___ T ___ R ___	

Register of Deeds Stamp & File Number

4. Lot No. _____, Recorded Plat _____
5. Private Claims _____

LIBER 3 PAGE 254

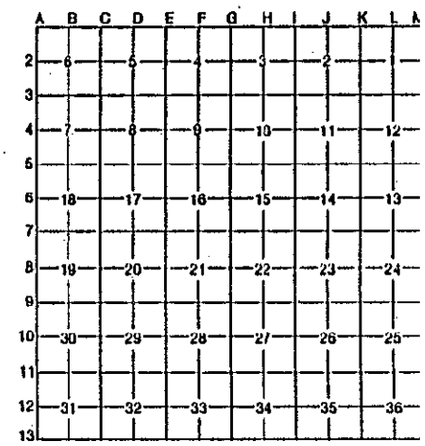

I, Marvin E. Myers, in a field survey on November, 1996, do hereby certify that under requirements of P.A. 74, Michigan P.A. of 1970, the corner points mentioned in lines 1 and 2 above were in conformance with regulations and rules therefore as required in the current manual of survey instructions of the United States Department of the Interior, Bureau of Land Management or by a decree of a Court of Law and/or that the corner points mentioned in lines 3, 4 and 5 above were in conformance with the rules of the Michigan Board of Professional Surveyors or by a Decree of a Court of Law; established, re-established, monumented, re-monumented, recovered, found as expressed below:

NOTE: Not more than 4 corners, all in the same town and range, may be recorded on this certificate.

A. Description of original monument and accessories and/or subsequent restoration:

CLO William Burt June 9, 1852
Mon.-Post
WIT: 9" Aspen N27°E 75 lks.
8" Aspen N07°W 67 lks.

US GLO G. Veal 1937
Mon.-Accepted intersection of roads as best available evidence. Set 6" dia. x 12" long concrete block to mark corner.
WIT: Set witness monuemnt 24" long x 12" dia. at base & 8" dia. at tip with 3½" dia Brass Tablet N50°E 68 lks. from which the following were taken:
12" B.Oak S41¼°W 131 lks.
10" B.Oak N86¼°W 179 lks.

G.D. Henning Oct. 30 1946
Mon.-Iron Bar
WIT: US 1937 wit. cor. N50°E 44.9'

R.T. Ostling July 1959
L.4 of plats, pg. 32
DEERHEART WOODS ANNEX
Mon.-MSHD pav't box

G.D. Henning Feb. 6, 1977
L.168, pg.127 (Crawford County)
Mon.-Fd. ½" bar in pav't box
WIT: ½" bar N46°29"W 46.98'
Conc. mon. S29°21'W 68.9'

L.2, pg.468
Mon.-MSHD pav't box

B. Description of corner evidence found and/or method applied in restoring or reestablishing corner:

Found monument box with 3/4" Iron Bar inside. Found accessories ½" Bar N46°W 46.98 feet and concrete monument S29°W 68.84 feet and accepted as the best available evidence of the position of the Original Corner

C. Description of monument for corner and accessories established to perpetuate locating the position of the corner:

Placed standard Crawford County Monument in pav't box
WIT: 8" W.Pine N30°E 60.78'
6" W.Pine N20°W 77.00'
Conc. mon. S35°W 68.84'
4" W.Pine S40°E 56.62'
½" Bar N46°29'W 46.98'
Monument is at intersection of roads

CRAWFORD COUNTY PEER GROUP APPROVAL
DATE NOV 22, 1996
Marvin E. Myers
Marvin E. Myers, P.S.
County Surveyor

STATE OF MICHIGAN
MARVIN E. MYERS
PROFESSIONAL SURVEYOR
No. 31600
LICENSED PROFESSIONAL SURVEYOR

Signed by Marvin E. Myers Date Dec 13, 1996

Surveyor's Michigan License No. 31600

FORM APPROVED BY MICHIGAN STATE BOARD OF PROFESSIONAL SURVEYORS, JAN. 28, 1971
REVISED MAY 14, 1975
REVISED JAN., 1983