LAND CORNER RECORDATION CERTIFICATE
Filing Requirement of Act 74, Mich. P.A. 1970 as Amended

For corners in

Dickinson
(County)

		Located In:	Corner Code #
1. Public Land Survey		T 42N R 29W	L9
		T R	
		T R	
	S	T R	
2. Property Controlling	S	T R	
in Section	S	T R	
3. Miscellaneous	S	T R	
Property in Sec.	S	T R	

Register of Deeds Stamp & File Number

4. Lot No. _____ , Recorded Plat_____

5. Private Claims

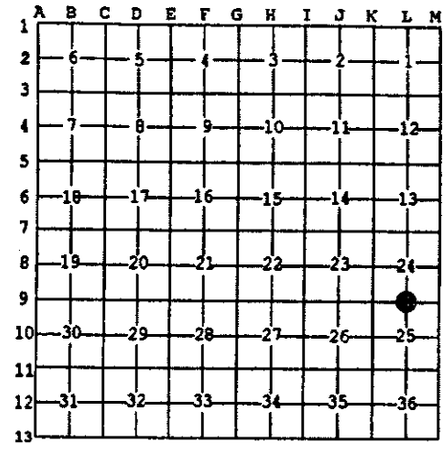

Aug 11 2004

I, Stephan J. Szyszkoski, in a field survey on _____, 20 ____ do hereby state that under requirements of P.A. 74, Michigan P.A. of 1970, the corner points mentioned in lines 1 and 2 above were in conformance with regulations and rules therefore as required in the current manual of survey instructions of the United States Department of the Interior, Bureau of Land Management or by a decree of a Court of Law and /or that the corner points mentioned in lines 3, 4 and 5 above were in conformance with the rules of the Michigan Board of Land Surveyors or by a Decree of a Court of Law; established, re-established, monumented, recovered, found as expressed below:

NOTE: Not more than 2 corners, all in the same town and range, may be recorded on this certificate.

A. Description of original monument and accessories and/or subsequent restoration:

(L9) Quarter corner common to Sections 24-25. Remonumented in Apr. 2001 by Robert F. Perkins, PS, and accepted by the Dickinson County Survey Peer Group as the official corner under Michigan PA 345 of 1990 on Dec. 10, 2001. Set Dickinson County Remon. Corner with Stamped Cap at mid-point on line betwteen Section corners 1/2 mile East and 1/2 mile West. Witnesses: 5" Maple N44W 26.93', 12" Lynn N31E 19.45', 12" Lynn S49E 4.15', 9" Ash S64W 46.20', Carsonite post S20W 1.7'.

B. Description of corner evidence found and/or method applied in restoring or reestablishing corner:

(L9) Found the 2001 monument as described and in good condition, at record bearing and distance from the two remaining witness trees: the 5" Maple and the 12" Lynn NE. The Lynn SE has been cut down. The 9" Ash was not recovered. Found no evidence of any tree having stood at S64W 46.20' from the corner monument. Left the monument in place and made two new witnesses as described below.

C. Description of monument for corner and accessories established to perpetuate locating the position of the corner:

(L9) Found Dickinson Co. monument.
Blazed, scribed and set measuring nails
in:
7" Sugar S16W 40.0' "1/4S NBT"
10" Sugar S54W 50.5' do
The 2001 wits:
5" Maple N44W 26.93'
12" Lynn N31E 19.45'
Distances were taken to a nail with tag
in side of tree.

STATE OF MICHIGAN
STEPHAN J. SZYSZKOSKI
LAND SURVEYOR
No. 33986
LICENSED LAND SURVEYOR

Signed by Steph J. Szyszkosl Date 8/18/04

Surveyor's Michigan License No. 33986

For the Michigan Department of Natural Resources, Office of Land and Facilities

FORM APPROVED BY MICHIGAN STATE BOARD OF PROFESSIONAL SURVEYORS, JAN. 28, 1971
Revised May 14, 1975
Revised Jan., 1983
Rervised Oct., 1995