SURVEY &
REMONUMENTATION

SEP 17 1999

SECTION

APPROVED LAND CORNER
P.A. 305 OF 1968
Houghton County
April 20, 1999
Robert W. Campbell

LAND CORNER RECORDATION CERTIFICATE
Filing Requirement of Act 74,
Mich. P.A. 1970

For corners in

Houghton County (County) Located In: Corner Code #

MARY SCHOOS 05/05/99 2
HOUGHTON COUNTY, REGISTER 15:07
LC 3/ 592 PAU Fee: 9.00
Page 1 of 1

1. Public Land Survey Section 7		T 54N	R 32W	A-5 (SW Corner Section 7)
		T____	R____	
	Section 12	T54N	R 33W	M-5 (SE Corner Section 12)
		T____	R____	
2. Property Controlling	S____	T____	R____	
in Section	S____	T____	R____	Seq. 2
3. Miscellaneous	S____	T____	R____	
Property in Sec.	S____	T____	R____	

Register of Deeds Stamp & File Number

4. Lot No. _____ , Recorded Plat _____
5. Private Claims _____

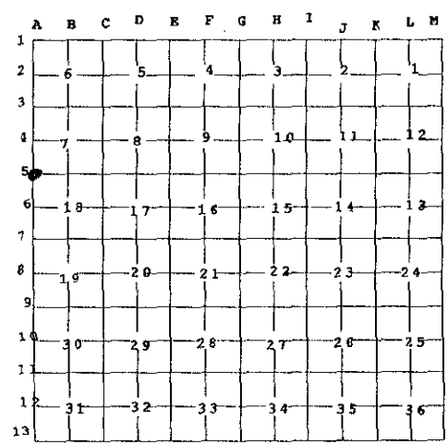

I, Michael T. Drewyor, in a field survey on December 22, 19 97 do hereby state that under requirements of P.A. 74, Michigan P.A. of 1970, the corner points mentioned in lines 1 and 2 above were in conformance with regulations and rules therefore as required in the current manual of survey instructions of the United States Department of the Interior, Bureau of Land Management or by a decree of a Court of Law and /or that the corner points mentioned in lines 3, 4 and 5 above were in conformance with the rules of the Michigan Board of Land Surveyors or by a Decree of a Court of Law; established, re-established, monumented, recovered, found as expressed below:

NOTE: Not more than 2 corners, all in the same town and range, may be recorded on this certificate.

A. Description of original monument and accessories and/or subsequent restoration:

SW ¼-Corner, Section 7: At 80.00 chains (meas. from S) set section post corner of Sections 12 & 13.

Maple 10, N 48° E, 10
Yellow Birch 8, N 53° W, 23

No evidence of original monument or accessories found. This line was originally surveyed by Deputy Surveyor.

B. Description of corner evidence found and/or method applied in restoring or reestablishing corner:

Found 2 ½" OD (2" ID) iron pipe 6" above grade. Iron is South of dirt road to Randy Roberts camp.

C. Description of monument for corner and accessories established to perpetuate locating the position of the corner:

All witness points in trees are PK nails and washers.

SW Corner of Section 7 – Found 2" ID iron pipe (description above).

Witnesses:

N 67° E,	19.66 ft.,	10" Maple
S 62° E,	5.49 ft.,	7" Fir
S 42° W,	7.77 ft.,	14" Maple
N 06° W,	19.52 ft.,	18" Maple

Signed by Michael T. Drewyor Date April 13, 1999
Surveyor's Michigan License No. 24245

FORM APPROVED BY MICHIGAN STATE BOARD OF PROFESSIONAL SURVEYORS, JAN. 28, 1971

REVISED MAY 14,1975
REVISED JAN., 1983
REVISED OCT., 1995

By: Hitch, Inc., P.C., Houghton, MI
Job #97012