

DEC 29 1996

COMMISSION

LAND CORNER RECORDATION CERTIFICATE
Filing Requirement of Act 74, Mich. P.A. 1970

of corners in
MANISTEE
(County)

Located In: _____ Corner Code # _____

Public Land Survey T 21N R 13W
T _____ R _____
T _____ R _____
T _____ R _____
T _____ R _____

Property Controlling S _____ T _____ R _____
in Section S _____ T _____ R _____
Miscellaneous S _____ T _____ R _____
Property in Sec. S _____ T _____ R _____

Lot No. _____ Recorded Plat _____
Private Claims _____

REGISTER'S OFFICE
MANISTEE COUNTY
#97-382 AT 10:55 a.m.
OCT 14 1997
Penny A. Rosen
REGISTER OF DEEDS

Register of Deeds Stamp & File Number

Kenneth L. Ross, in a field survey on July 31 19 97,
do hereby certify that under requirements of P.A. 74, Michigan P.A. of 1970, the corner points mentioned
in lines 1 and 2 above were in conformance with regulations and rules therefore as required in the
current manual of survey instructions of the United States Department of the Interior, Bureau of Land
Management or by a decree of a Court of Law and/or that the corner points mentioned in lines 3, 4 and 5
above were in conformance with the rules of the Michigan Board of Land Surveyors or by a Decree of a
Court of Law; established, re-established, monumented, re-monumented, recovered, found as
expressed below:

NOTE: Not more than 4 corners, all in the same town and range, may be recorded
on this certificate.

A. Description of original monument and accessories and/or subsequent restoration:
a-13-m.c. Meander Corner on the Township Line, at the west Shore of Sand Lake.

1837, John Brink, G.L.O.
Used a 10" White Pine for the meander corner
No witness recorded

1958, George Blass, RLS # 5489
Set 2" Pipe, fill with concrete w/ 3 1/4" brass cap
as of Liber 4, page 34-35
#1 White Oak 7" N 27° W 30.13' (scr. NBT)
#2 White Oak 5" S 87° W 42.55' (scr. NBT)
#3 White Oak 6" N 52° E 83.25' (scr. NBT)
#4 Cusp of a 16"x 18" stone North 2.00'

	A	B	C	D	E	F	G	H	I	J	K	L	M
1													
2	6	5	4	3	2	1							
3													
4	7	8	9	10	11	12							
5													
6	18	17	16	15	14	13							
7													
8	19	20	21	22	23	24							
9													
10	30	29	28	27	26	25							
11													
12	31	32	33	34	35	36							
13													


B. Description of corner evidence found and/or method applied in restoring or reestablishing corner:

a-13-m.c. Meander Corner on the Township Line, at the west shore of Sand Lake.

On July 31, 1997, I Kenneth Ross and Kevin Pritchard (survey tech.) found a 2" steel pipe with a 3 1/4" brass cap, stamped to identify this corner, this corner 1.8 of a foot above the ground and is placed 40 feet west of the shore and 20 feet North of the shore of Sand Lake.

Condition of record witnesses are: #1 Found in good condition #2 Found in good condition
#3 Gone #4 Found in good condition

Corner A-13 m.c. ratified by the Manistee County Peer Group
according to the county plan adopted pursuant to P.A. 345 of 1990,
as amended, (being the State Survey and Remonument Act, MCL 54.261
et seq.). Date of Peer Review: OCT 7 1997
Anthony M. Slawski

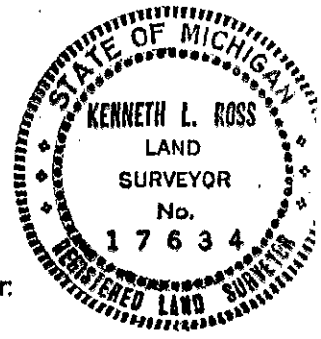

C. Description of monument for corner and accessories established to perpetuate locating the position of the corner:

a-13-m.c. Meander Corner on the Township Line, at the west Shore of Sand Lake.

I accepted George Blass's 2" steel pipe with 3 1/4" brass cap as a substantial marker for this corner,
and is accepted as a careful and faithful re-establishment of the position of the original corner.

(ext. BT #1) White Oak 18" N 27° W 31.00' (set 60d spike in NW side of tree)
White Oak 12" S 89° W 43.05' (set 60d spike in North side of tree)
White Oak 8" N 40° W 15.45' (set 60d spike in NW side of tree)
Black Oak 18" N 28° E 32.16' (set 60d spike in NW side of tree)

Signed by Kenneth L. Ross Date August 22, 1997
Surveyor's Michigan License No. 17634