

DEC 2 9 1996

COMMISSION

LAND CORNER RECORDATION CERTIFICATE
Filing Requirement of Act 74, Mich. P.A. 1970

corners in

Manistee Located In: Corner Code #
(County)
Public Land Survey T 21N R 17W M-06 MC
T R North of the
T R East 1/4 Corner
T R Section 13
Property Controlling S T R
in Section S T R
Miscellaneous S T R
Property in Sec. S T R

REGISTER'S OFFICE
MANISTEE COUNTY

97-387 at 3:15pm

OCT 17 1997

REGISTER OF DEEDS

Register of Deeds Stamp & File
Number

Lot No. , Recorded Plat
Private Claims

Anthony M. Slawinski, in a field survey on July 18, 19 97 do hereby state that
er requirements of P.A. 74, Michigan P.A. of 1970, the corner points mentioned in lines 1 and 2
ve were in conformance with regulations and rules therefore as required in the current manual of
vey instructions of the United States Department of the Interior, Bureau of Land Management or
a decree of a Court of Law and for that the corner points mentioned in lines 3, 4 and 5 above
are in conformance with the rules of the Michigan Board of Land Surveyors or by a Decree of a
urt of Law; established, re-established, monumented, recovered, found as expressed below:

OTE: Not more than 2 corners, all in the same town and range, may be recorded
on this certificate.

Description of original monument and accessories and/or subsequent restoration:
-06 MC Meander Corner North of the East 1/4 Corner of section 13, T21N., R17W.

at by John Brink in 1837

5.73 chains Fell into line on margin of lake

et Post

B. Oak 10" N 66 1/2° W 17 links (Gone)
W. Oak 7" N 07 1/2° E 16 links (Gone)

Description of corner evidence found and/or method applied in restoring or reestablishing corner:

-06 MC Meander Corner North of the East 1/4 Corner of section 13, T21N., R17W.

Computed the East 1/4 Corner by intersecting the North-South Range Line and the Indian Reservation Line, which
is common to the Oak Hill Plat and the First Rietz Park Addition Plat, and used government measure to go North
from the computed East 1/4 Corner to set the Meander Corner. This was done on the advice of Bob Griffin on
uly 18, 1997.

Note: The East 1/4 Corner of Section 13, T21N., R17 W. falls in Manistee Lake.

Also referenced:

ALO Field Notes by John Brink (1837) Book 1, Page 283

Oak Hill Plat (1890), Vol. 2 of Plats, Page 7

Sketch Showing Relationship of East 1/4 Corner, Meander
Corners and Witness Corners by Abonmarche. (1997)

Map of Maxwell Town (1874),
Liber 19, Page 592

First Rietz Park Addition Plat (1910),
Vol. 2 of Plats, Page 7


Survey Map by Janema (April (1994)

Description of monument for corner and accessories established to perpetuate locating the position of the corner:

M-06 MC Meander Corner North of the East 1/4 Corner of section 13, T21N., R17W.

On July 18, 1997, I installed a Manistee County Monument, 2" above grade by going government measure from
the computed East 1/4 corner of Section 13, T21N., R17W, to the Meander Corner as a careful and faithful
re-establishment of the position of the original corner, and witnessed by:

3. N 06° E 105.45' Power Pole (Set spike in Northeast side)
4. N 02° W 80.55' Southwest corner of metal structure
5. N 60° W 91.25' 4" Sycamore (Spike in the Southwest side)
6. N 73° W 105.92' Set Rail Road Spike in East End of Rail Road Tie
7. S 02° W 2901.44' Southeast Section Corner, Sec. 13, T21N., R17W.

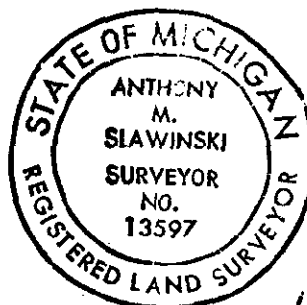

Signed by Anthony M. Slawinski

Date 10-2-97

Surveyor's Michigan License No. 13597

	A	B	C	D	E	F	G	H	I	J	K	L	M
1													
2	6		5		4		3		2		1		
3													
4	7		8		9		10		11		12		
5													
6	18		17		16		15		14		13		
7													
8	19		20		21		22		23		24		
9													
10	30		29		28		27		26		25		
11													
12	31		32		33		34		35		36		
13													

ratified by the Manistee County Peer Group
according to the county plan adopted pursuant to P.A. 345 of 1990,
as amended, (being the State Survey and Remonument Act, MCL 54.261
et. seq.).
Peer Review: OCT 7 1997
Anthony M. Slawinski