

# RE-RECORD

\$ 4.00 REMONUMENTATION

\$ 10.00 DEED

DEC 95 10:25 A.M. RECEI 1CA

RECORDED

FOREST E. YOUNGBLOOD, REGISTER  
WAYNE COUNTY, MI

EDS

For corners in

WAYNE  
(County)

Located In:  
City of Detroit

Corner Code #

#017

Protracted  
Location

Seg. 1 Pg 754

Seg. 2 Pg 865

28660 865

Liber 20465 Page 754

Compliance with  
ACT 345, P.A. 1990

APPROVED ON: 12-11-95 DPD  
WAYNE COUNTY REMONUMENTATION  
FEER GROUP COMMITTEE

Register of Deeds Stamp & File Number

1. Public Land Survey

T 2S R 12E

T R

T R

T R

2. Property Controlling  
in Section

S T R

S T R

3. Miscellaneous  
Property in Sec.

S T R

S T R

4. Lot No. , Recorded Plat

5. Private Claims Line Common to P.C. 27 and P.C. 227

Church St., East of 12th St.

I, George M. Platz, in a field survey on December 8, 1995, do hereby certify that under requirements of P.A. 74, Michigan P.A. of 1970, the corner points mentioned in lines 1 and 2 above were in conformance with regulations and rules therefore as required in the current manual of survey instructions of the United States Department of the Interior, Bureau of Land Management or by a decree of a Court of Law and/or that the corner points mentioned in lines 3, 4 and 5 above were in conformance with the rules of the Michigan Board of Land Surveyors or by a Decree of a Court of Law; established, re-established, monumented, re-monumented, recovered, found as expressed below:

NOTE: Not more than 4 corners, all in the same town and range, may be recorded on this certificate.

A. Description of original monument and accessories and/or subsequent restoration:  
Line Common to P.C. 27 and P.C. 227

| A  | B  | C  | D  | E  | F  | G  | H | I | J | K | L | M |
|----|----|----|----|----|----|----|---|---|---|---|---|---|
| 2  | 6  | 6  | 4  | 3  | 2  | 1  |   |   |   |   |   |   |
| 3  |    |    |    |    |    |    |   |   |   |   |   |   |
| 4  | 7  | 8  | 8  | 10 | 11 | 12 |   |   |   |   |   |   |
| 5  |    |    |    |    |    |    |   |   |   |   |   |   |
| 6  | 18 | 17 | 16 | 15 | 14 | 13 |   |   |   |   |   |   |
| 7  |    |    |    |    |    |    |   |   |   |   |   |   |
| 8  | 19 | 20 | 21 | 22 | 23 | 24 |   |   |   |   |   |   |
| 9  |    |    |    |    |    |    |   |   |   |   |   |   |
| 10 | 30 | 29 | 28 | 27 | 26 | 26 |   |   |   |   |   |   |
| 11 |    |    |    |    |    |    |   |   |   |   |   |   |
| 12 | 31 | 32 | 33 | 34 | 35 | 36 |   |   |   |   |   |   |
| 13 |    |    |    |    |    |    |   |   |   |   |   |   |

CITY OF DETROIT

The eastern line of P.C. 227 was originally surveyed as one tract of land in 1810. The western line of P.C. 27 was originally surveyed as two separate tracts of land, the first in the year 1810 and the second most likely in 1829 (see research dossier for sketch and notes). Posts were originally set at the corners only and no line stakes are called out. Many subdivisions have been platted adjacent to this line. The City of Detroit Survey Section has assembled and maintained their "Cartographic Maps" from record plat data and field work. These maps have been relied upon for a great number of years and are considered the best assembled collection of written evidence available. To the best of my knowledge, there has never been any subsequent restoration of this line, excepting the plats which were done long ago.

B. Description of corner evidence found and/or method applied in restoring or reestablishing corner:  
Line Common to P.C. 27 and P.C. 227

A complete analysis of this line from its southern beginnings at the Detroit River to its northern terminus has been field measured by Spalding DeDecker & Associates, locating building lines, street lines, and alley lines at various positions (see research dossier). It is my conclusion that three line orientation changes occur on this line. At this time, I do not have a final answer for the ENTIRE line. The orientation of the middle portion of this line, between Michigan Ave. and Grand River, will be determined under a future remonumentation program contract. The northern portion and southern portion of this line has been determined and the specific points held as good with their relationship to other various points field measured are labeled in the research dossier.

C. Description of monument for corner and accessories established to perpetuate locating the position of the corner:  
Line Common to P.C. 27 and P.C. 227 -- See sketch on the back of this sheet.

(B) Set 4"x 36" Concrete Monument w/Aluminum Disk stamped "WAYNE COUNTY REMONUMENTATION, SPALDING-DEDECKER, PS 38121" in a Monument Box Located in the approximate centerline of Church Street, approximately 190'+/- East of the centerline of Rosa Parks (12th Street). The location of this property controlling monument is accepted as a careful and faithful determination of this private claim line based upon all known evidence.

Az. 80° 82.06'; Set P.K. Nail w/WCR Tag in North Face of a Utility Pole

Az. 158° 13.06'; Set P.K. Nail w/WCR Tag in East Face of a Utility Pole

Az. 244° 108.83'; Set P.K. Nail w/WCR Tag in North Face of a Utility Pole

Az. 342° 24.90'; Set P.K. Nail w/WCR Tag in Concrete Sidewalk

Signed by George M. Platz

Date 12-11-95

Surveyor's Michigan License No. 38121

Re-REREORD TO CORRECT RANGE


DPD

Spalding - DeDecker & Assoc. SM94-44 & SM95-28

FORM APPROVED BY MICHIGAN STATE BOARD OF LAND SURVEYORS, JAN. 28, 1971

REVISED MAY 14, 1971

REVISED JAN. 1983

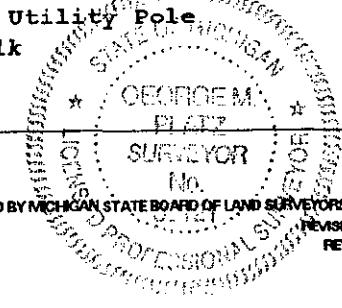

4F

10L

DPD