RFM

2000

SECTION

LAND CORNER RECORDATION CERTIFICATE

Filing Requirement of Act 74, Mich. P.A. 1970

For corners in

Washtenaw (County)

	Located In:		Corner Code #
1. Public Land Survey	T 2S	R 5E	I-2
	T___	R___	___
	T___	R___	___
	T___	R___	___
2. Property Controlling	S___ T___	R___	___
in Section	S___ T___	R___	___
3. Miscellaneous	S___ T___	R___	___
Property in Section	S___ T___	R___	___

-Copy-

5094718
Page: 1 of 1
02/07/2000 02:55P
Peggy M. Haines - Washtenaw Co. CORREM L-2 P-309

Register of Deed Stamp & File Number

4. Lot No. _____, Recorded Plat _____

5. Private Claims _____

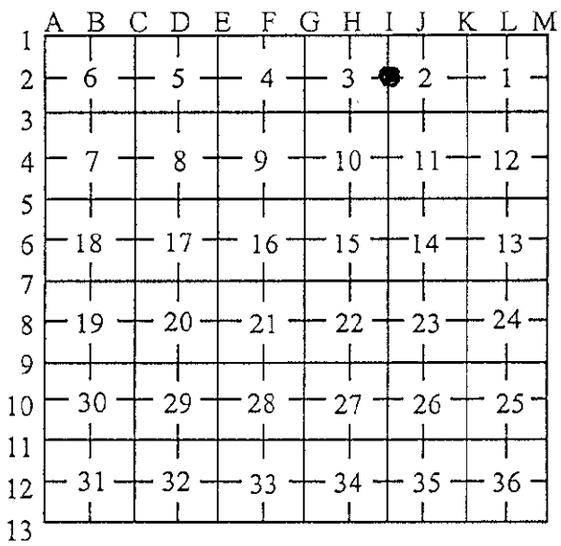

I, Thomas L. Sutherland, in a field survey on 12-17-1999 do hereby state that under requirements of P.A. 74, Michigan P.A. of 1970, the corner points mentioned in lines 1 and 2 above were in conformance with regulations and rules therefore as required in the current manual of survey instructions of the United States Department of the Interior, Bureau of Land Management or by a decree of a Court of Law and/or that the corner points mentioned in lines 3, 4 and 5 above were in conformance with the rules of the Michigan Board of Land Surveyors or by a Decree of a Court of Law; established, re-established, monumented, recovered, found as expressed below:

NOTE: Not more than 2 corners, all in the same town and range, may be recorded on this certificate.

A. Description of original monument and accessories and/or subsequent resortation:

G.L.O. 1819, Field Notes
20" Elm S86°E 10 Links
11" Ironwood N5°E 17 Links

Plat of "Loch Alpine" Liber 8 of Plats, Pages 26-28.

Undated survey of unknown origin.

Washtenaw Engineering, N.N. Fahrner #17620 12/19/97, Survey 7535

B. Description of corner evidence found and/or method applied in restoring or re-establishing corner:

Found nothing. Set corner (PK Nail and remonumentation tag stamped 24620 in driveway to 4670 Midway Drive) on line between I-1 and I-3 where said line intersects the Easterly extenstion of the Southerly line of Westgate Drive, lot 156, lot 160, and lot 161 of Loch Alpine, 1374.33 feet East of the Southeast corner of lot 156.

C. Description of monument for corner and accessories established to perpetuate locating the position of the corner:

PK Nail and remonumentation tag stamped 24620 in asphalt driveway to 4670 Midway Drive.
SW corner of garage North 63.06
NW'ly edge of asphalt driveway N55°W 2.66
22" Maple N45°W 20.74 to remon tag on SW Side
SE corner of concrete walk N02°E 43.19
24" Walnut N40°E 61.92 to remon tag on SE Side
18" Maple S75°E 24.85 to remon tag on S'ly Side
12" Maple S55°W 30.41 to remon tag on SE Side

I conclude after careful study of the record documentation and field observation, that this corner is accepted as the best available evidence of the position of the original corner.

STATE OF MICHIGAN THOMAS L. SUTHERLAND No. 24620 REGISTERED LAND SURVEYOR

APPROVED
DATE 12/20/99
CO. REP. KA

Signed by: Thomas L. Sutherland Date 12/20/99

Surveyor's Michigan License No. 24620