MARQUETTE COUNTY REMONUMENTATION

CORNER RATIFICATION FORM

LOCATION

T. 45 N., R. 26 W.

SURVEY &
REMONUMENTATION
FEB 28 2000
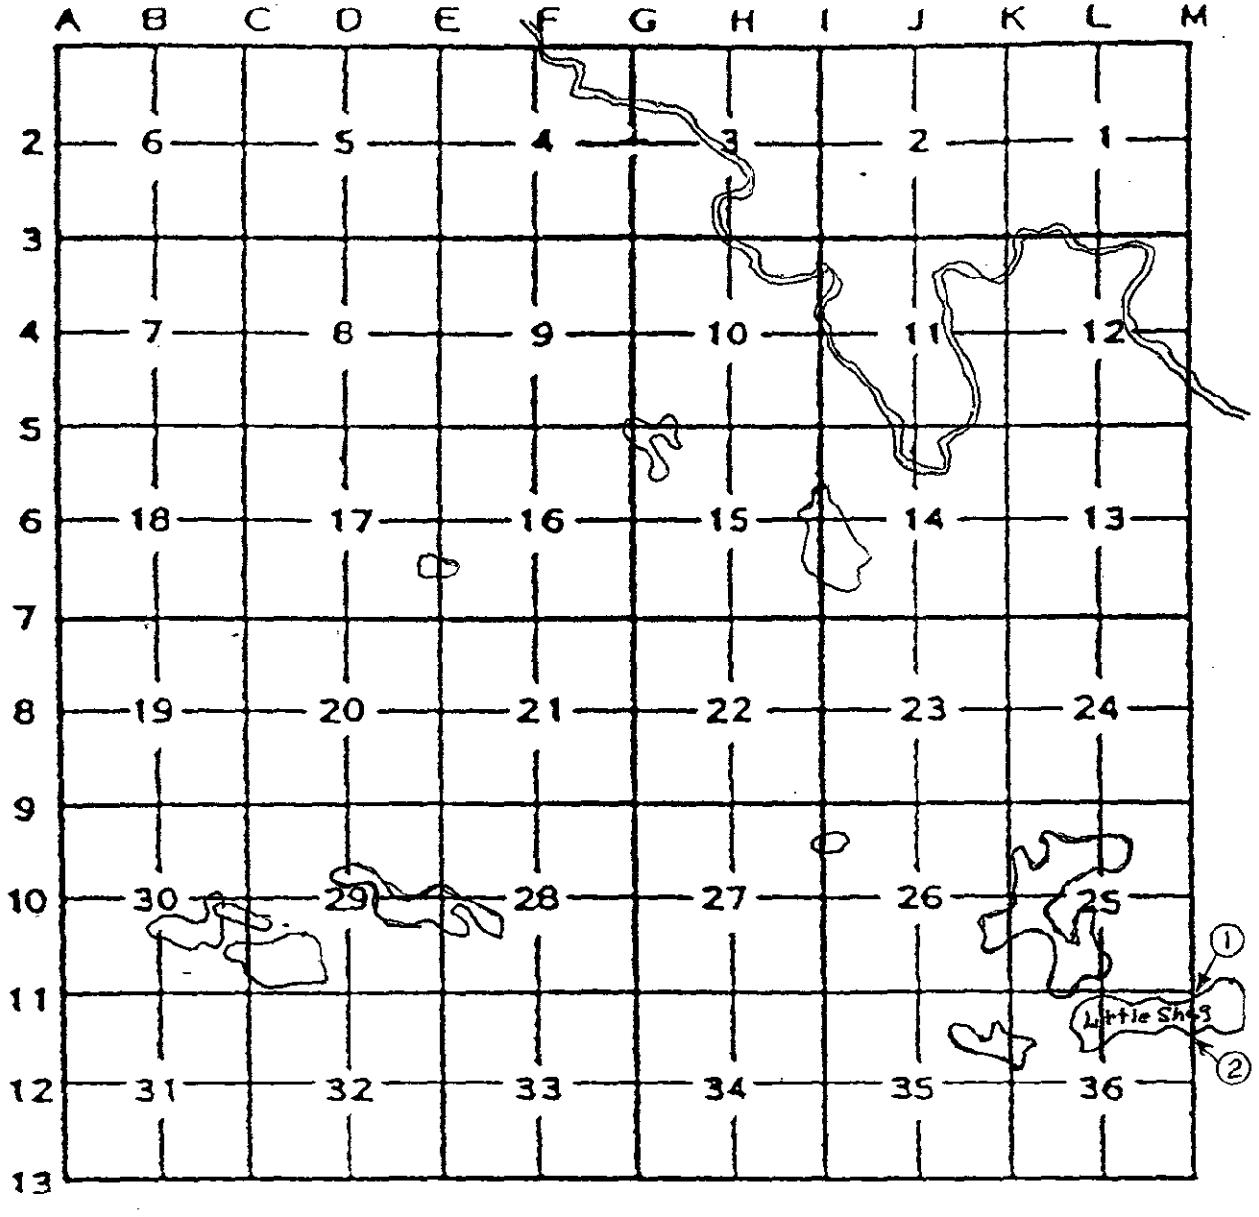
SECTION