Township No. 49 N. Range No. 16 W. Mer. Michigan

36-7

Meanders of									
Date	Courses	Chs Lks	Date	Courses	Chs Lks	Date	Courses	Chs Lks

Lake Superior

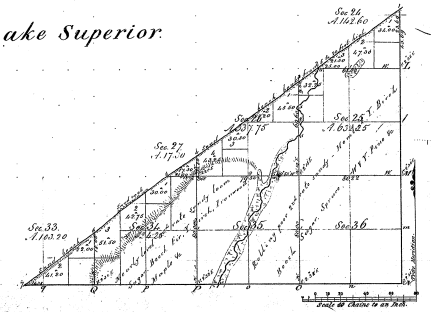

Total number of Acres 3 037.35

Surveys Designated.	By Whom Surveyed.	Date of Contract.	Amount of Surveys. Ch.	Lks.	When Surveyed.	When Charged in the Gen.l Land Off.
Township lines.	William A. Burt	April 1 1841	6	08	1847	1st Quar. 1848
Subdivisions.	William Ives	Boundaries on 21	08	21		3rd Quar. 1850

The above Map of Township No. 49 N. of Range No. 16 West of the Principal Meridian, Michigan, is strictly conformable to the field notes of the survey thereof on file in this Office, which have been examined and approved.

Charles Nelson
Surv.r Genl

Surveyor General's Office
Detroit, September 2 1851