Re-Survey.

Township No. 29 N. Range No. 8 W. Mer. Mich

15-8

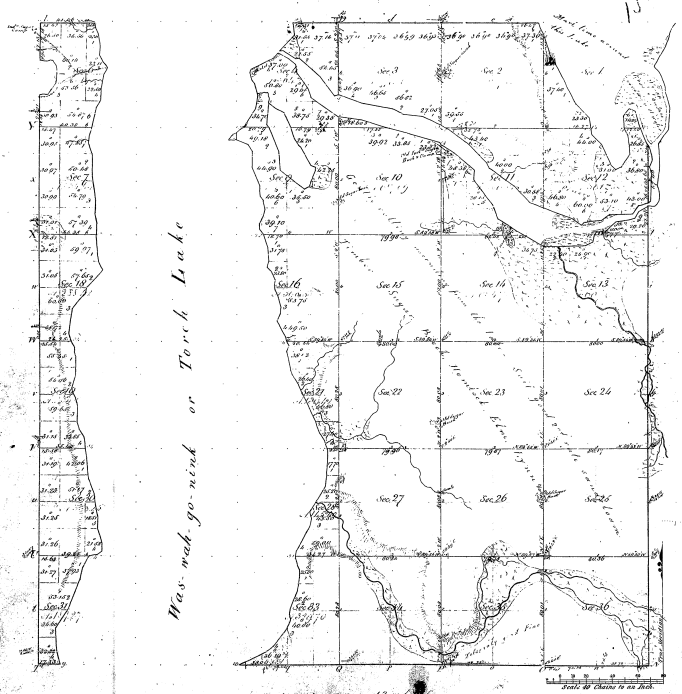

Meanders of								
Posts	Courses	Ch's Lks	Posts	Courses	Ch's Lks	Posts	Courses	Ch's Lks

Total number of Acres 13,964.60

Surveys Designated.	By Whom Surveyed.	Date of Contract.	Amount of Surveys. M.	Ch's	Lks	When Surveyed.	When Charged in the Surv'r Gen'l acc'n
Township lines &c.	Lucius Lyon	April 19 1850	11	74	27	3rd June 1850	
Subdivisions	Lucius Lyon	April 19 1850	62	48	30	3rd June 1850	

The above Map of Township No. 29 North of Range No. 8 West of the Principal Meridian, Michigan, is strictly conformable to the field notes of the survey thereof, on file in this Office, which have been examined and approved.

Surveyor General's Office
Detroit July 31 1851

Charles Hobbs Sur'r Genl.