Township No. 46 N Range No. 34 W Mer: Mich.

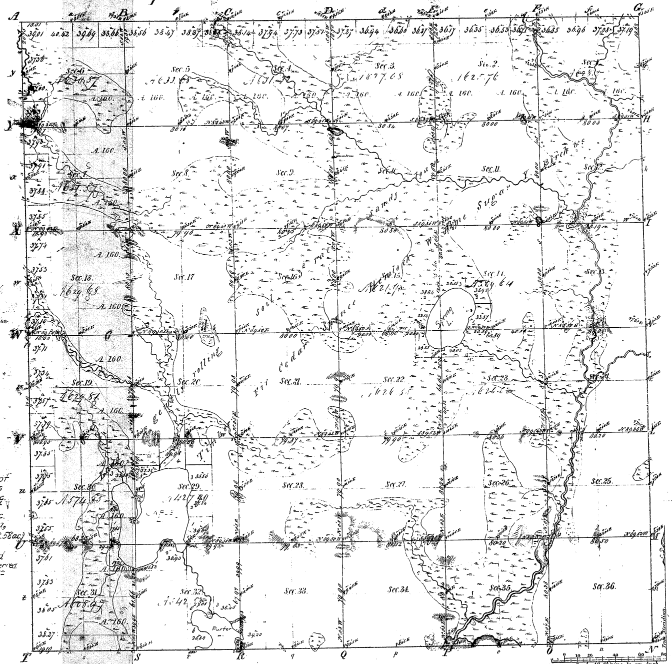

The A. of Sec. 29 is 430.48 ac. and not 427.90 ac. as given, Lot 7 (2.58 ac) was omitted M. S. Gerred 8/5/42

Meanders of								
Posts	Courses	Ch. Lk.	Posts	Courses	Ch. Lk.	Posts	Courses	Ch. Lk.

Total number of Acres 22,419.98

Surveys Designated	By Whom Surveyed	Date of Contract	Amount of Surveys	When Surveyed	When pd. for and chd. in the Sur. Gen's acct.
Township lines	Austin Burt	Sept. 7. 1846	M. 11 - Chs. 77 - Lks. 81	3d Quar. 1846	—
Subdivisions	Z. B. Searls	Bond Dec 11.1852	04 - 02 - 02	3d Quar. 1852	—

The above Map of Township No. 46 N of Range No. 34 West of the Principal Meridian of Michigan is strictly conformable to the field notes of the survey thereof on file in this Office, which have been examined and approved.

Surveyor Generals Office, Detroit November 14 1853

Leander Chapman
Sur. Gen.