Township N.° 10 N., Range N.° 9 West Mer. Mich.

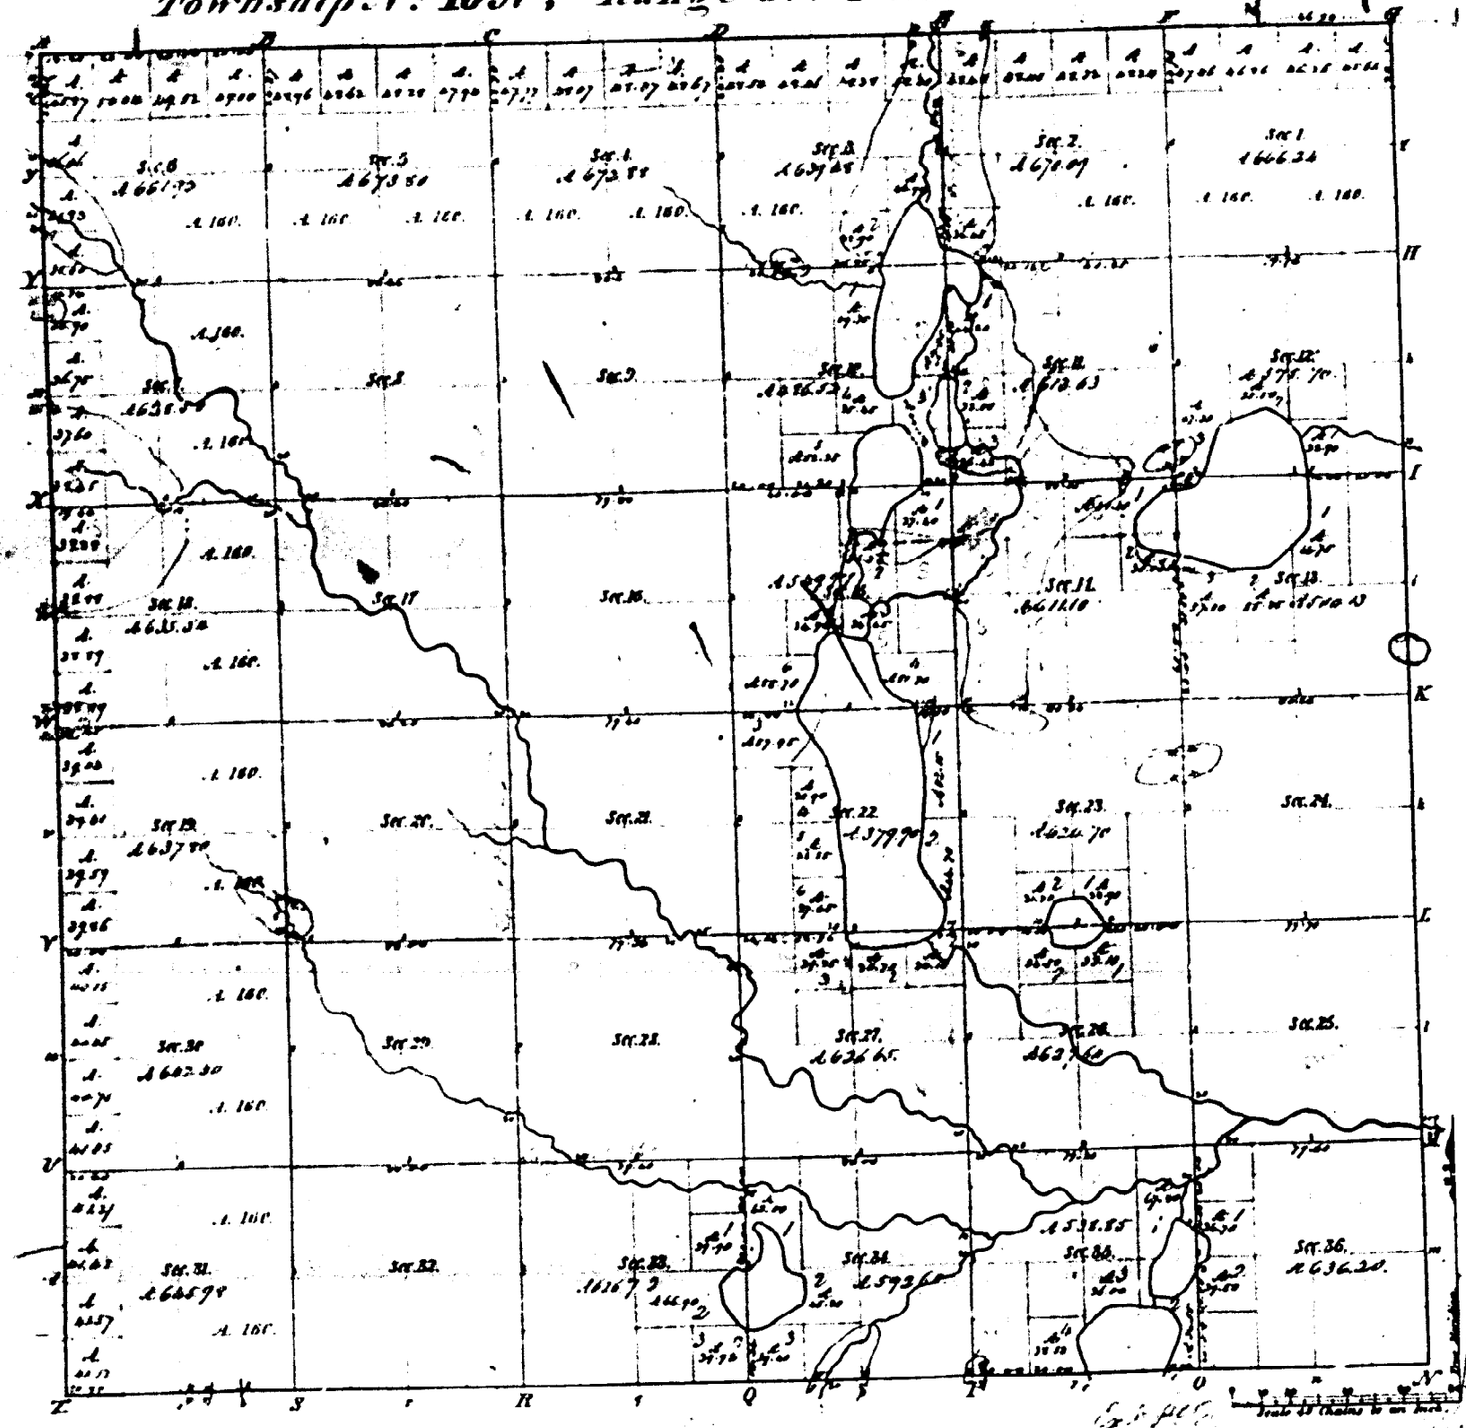

Meanders of Lakes.

	From	Courses	(N E S W)	Poles	Courses	(N E S W)	Poles	Courses	(N E S W)
Lake in Sec. 15									
32.	N 30 E	15.00		7.	S 4 E	5.00			
	North	2.00			South	28.00			
	N 35 E	14.00			S 85 W	28.00			
	S 70 E	15.00			N 55 W	12.00	17.	S 79 W	6.75
	South	16.00			N 75 W	16.00			
	S 30 E	10.00		8.	N 63 W	8.05			
21.	S 66 E	16.25		Lake in Sec. 14					
	S E	28.00		26.	South	12.00			
	South	15.00			S 26 E	8.00			
	S 6 W	28.00			S 75 E	5.00			
	S 30 E	15.00			S 60 E	8.00			
	South	5.00			S 25 E	15.00			
14.	S E	7.00			S 66 E	5.00			
	N 45 W	5.00		27.	S 58 E	3.00			
	S 15 W	15.00			S W	18.00			
	West	9.00			N 20 W	9.00			
	N 70 W	5.00			S 50 W	12.00			
21.	N 10 W	3.25			S 80 W	12.00			
	North	15.00			S 10 W	10.00			
	N 5 W	25.00		34.	S 23 W	3.25			
	N 10 W	20.00		Lake in Sec. 11					
	N 22 W	10.00		11.	N 70 W	6.00			
22.	N 30 W	13.00			N 10 W	9.00			
Lake in Sec. 35					N 25 E	14.00			
1.	N 25 E	15.00			North	8.00			
	N 30 W	10.00		12.	N 55 E	3.25			
	West	22.00			N 15 E	3.00			
	S 85 W	15.00			South	10.00			
2.	S 10 E	13.00			S 35 E	7.00			
Lake in Sec. 25 & 26					South	7.00			
3.	N 50 E	6.00		11.	S 50 W	6.00			
	North	8.00		Lake in Sec. 23, 24, 25 & 26					
	N 35 W	3.00		18.	South	2.00			
4.	N 70 W	3.25			West	1.00			
	N 55 W	7.00			S 15 W	15.50			
	S 20 W	15.00			South	28.00			
	S 55 W	8.00			S 5 W	5.00			
	South	12.00			S 10 E	7.00			
	S 65 E	10.00			S 70 E	10.00			
	N 30 E	12.00			North	6.00			
5.	N 5 E	1.00			N 30 E	21.50			
					N 5 E	10.00			
Lake in Sec. 23 & 26				13.	N 66 E	1.50			
12.	N 20 E	10.00			N 30 E	18.00			
	N 85 E	10.00			N 55 E	6.00			
	North	12.00			North	12.50			
9.	N 5 W	1.00		14.	N 5 W	2.00			
	N 35 W	10.00			N 65 W	11.00			
	N 50 W	15.00		15.	N 70 W	2.00			
	North	5.00			N 30 W	15.00			
10.	N 30 W	1.00			N 7 W	5.00			
				16.	S 24 W	25.00			
Lake in Sec. 12, 13 & 14				Lake in Sec. 9, 10 & 14					
5.	N 52 W	13.00		17.	N 12 W	12.00			
	N 10 W	2.00			N W	2.00			
	N 3 W	12.00			N 55 E	10.00			
	N 10 E	2.00		16.	N 60 E	2.00			
	N 30 E	2.00			N 25 E	7.00			
R	Gore	2.00			N 15 W	5.00			
	Gore	6.00			N 25 W	2.50			
L	N 30 E	6.00			N 5 E	3.00			
	N 20 E	20.00			S 80 E	3.00			
	N 70 E	12.00			S 25 E	16.00			
	S 50 E	12.00			S 70 E	6.00			
	S 10 E	12.00							

Total number of Acres 23,011.87

Surveys Designated	By Whom Surveyed	Date of Contract	Amount of Surveys	When Surveyed	When plat was sent to the Surr. Gen.l Office
Township lines	A. T. Brookfield	Oct. 31st 1836	N. 0 E. 87 - 27	3rd Q. 1837	3rd Q. 1838
Subdivisions	Chas. W. Whitneal	Mar. 1st 1837	74 - 11 - 13	3rd Q. 1837	1st Q. 1839

The above Map of Township No. 10 North of Range No. 9 West of the Principal Meridian Michigan is strictly conformable to the field notes of the survey thereof on file in this Office which have been examined and approved.

Surveyor Generals Office
Cincinnati Feb. 26th 1839

Surveyor General