Township No. 29 N. Range No. 17 W Mer. Mich.

Manistee Reserve.

17-29

17-29

Meanders of					
Pts.	Courses	Dist.	Pts.	Courses	Dist.

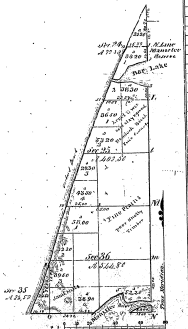

LAKE MICHIGAN.

Total number of Acres 1042.80

Surveys Dependated.	By Whom Surveyed.	Date of Contract.	Amount of Surveys M. Ch. Lks.	When Surveyed.	When Changed to the Surv'd Dim'n acc'd
Township lines	Moses Warren	Sept. 6 1836	2 54 51	Aug. 1837	
Subdivisions	D. Mullen	April 27 1837	2 54 51	Sept. & Oct. 1837	

The above Plat of Township 29 N. of Range 17 W. of the Principal Meridian, Michigan, is strictly conformable to the field notes of the survey thereof on file in this Office, which have been examined and approved.

Surveyor General's Office
Detroit, Mich. 5 1838

Lucius Lyon, Surv. Gen.