Re-survey

Township. N.o 23 N. Range N.o 9 W. Mer. Mich.

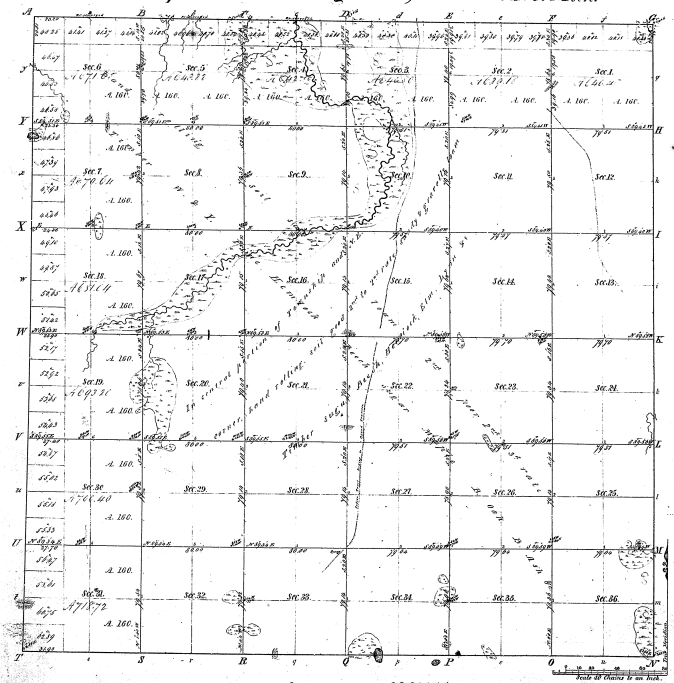

Meanders of

Poste Courses	Chs.	Lks.	Poste Courses	Chs.	Lks.	Poste Courses	Chs.	Lks.

16-29

Total number of Acres. 23,341.41

Surveys Designated.	By Whom Surveyed.	Date of Contract	Amount of Surveys	When Surveyed	When Approved and Rec.d in the Surr. Gen.l Office
Township lines	John Brunk	Nov.r 12th 1836.	24 72 00	7th Octo. 1838	
Subdivisions	Wm. Chandler	May 21st 1832	169 77 10	2nd & 3rd Sept. 1839	

The above Map of Township N.o 23 N. of Range N.o 9 W. of the Principal Meridian of Michigan is strictly conformable to the field notes of the survey thereof on file in this Office which have been examined and approved.

Surveyor Generals Office
Detroit January 9. 1840.

Saml. Ch. Sherman
Surr. Genl.