


14-5117-11
 Township N^o 31. N. Range N^o 6 E. Mer. Mich.

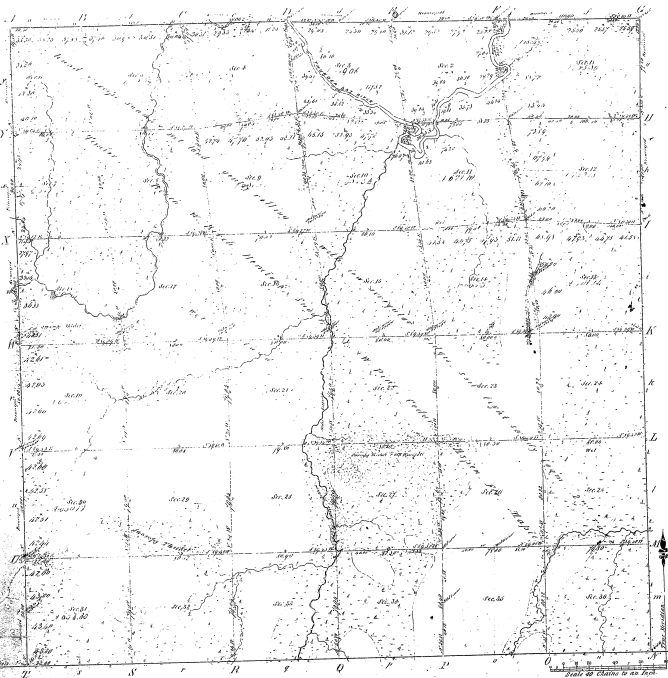







