Re Survey.

Township No 19. N. Range No 1 E. Mer. Mich.

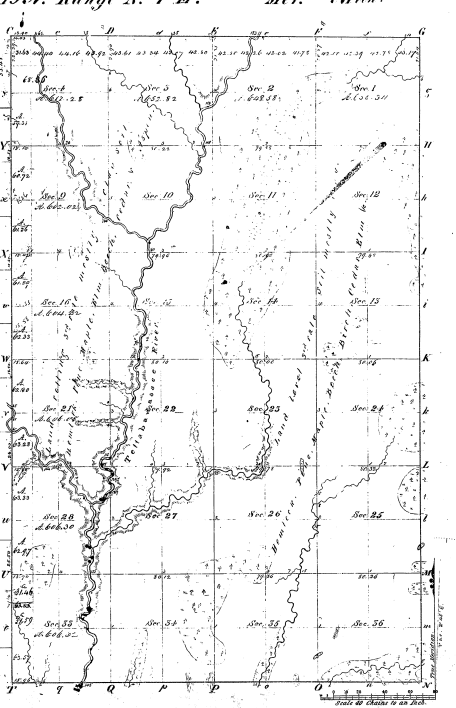

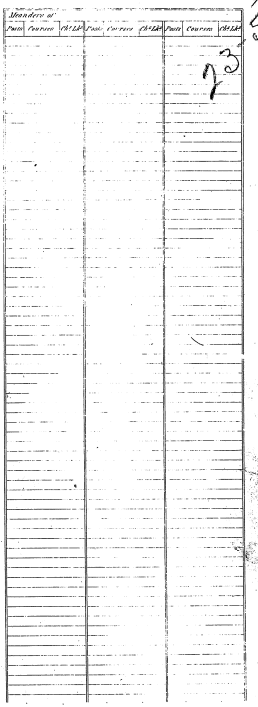

Total number of Acres 15189 26

Surveys Dsitgnated.	By Whom Surveyed	Date of Contract.	Amount of Surveys. M.	Ch.	Lks.	Wm. Surveyed.	When Accepted or the Survey Rejected.
Township South	Jas. Graham	Nov 10, 1836					
N. & W. Boundaries	Alfred Allen	Jan 10, 1837	12	71	50	2nd Dec 1837	
Subdivisions	Edmund Rice	Jan 10, 1837	57	61	56	2nd Dec 1837	

The above Map of Township No 19 N. of Range No 1 East of the Principal Meridian Michigan is strictly conformable to the field notes of the survey thereof now on file in this Office, which have been examined and approved.

Surveyor Generals Office
Detroit June 19 1838

Lucius Lyon, Surv. Genl.

Plat of Survey