


Plat of

Montague Island in Silver Lake

Sec. 6, Tp. 26 N., R. 11 W., Mich. Mer., Michigan.
Surveyed by C. F. Toller, U.S. Dep. Surveyor April 5th to 6th 1902,
under special instructions from the Com' G.L.O., dated March 13th 1902.

Scale 10 chs. to one inch.

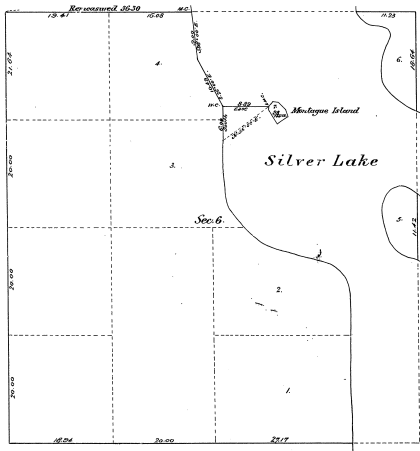

DEPARTMENT OF THE INTERIOR,
General Land Office,
Washington, D.C. June 30 - 1902.

The above plat of Montague Island, in Silver Lake, in Sec. 6, Tp. 26 N., R. 11 W., Mich. Mer., Michigan, is a correct plat of a survey executed by C. F. Toller, U.S. Deputy Surveyor, in pursuance of special instructions from the Commissioner of the General Land Office, bearing date March 13th 1902, and is strictly conformable to the field notes thereof on file in this office, which have been examined and approved.

Russell A. Howard
Commissioner and ex-officio
Surveyor General for Michigan.

16-18

16-18