


Township No. 30 N Range No. 15 W Mer. Mich.

Part of S. Marquette Island

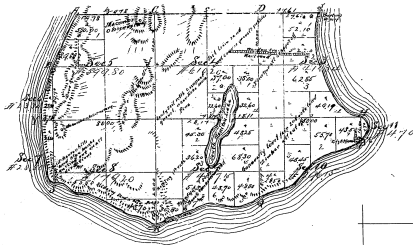

Lake Michigan.



A copy of this Diagram furnished
to the official Register at Sault Ste. Marie
23rd day
Surveyor General's Office
April 25 1850

Total Number of Acres 2655.64

Survey Disposition	By Whom Surveyed	Date of Commencement	When Began	When Ended	When Closed
Township Lines	<u>O. R. Anderson</u>	<u>April 27 1847</u>	<u>27</u>	<u>31</u>	<u>of 1847</u>
Subdivisions	<u>O. R. Anderson</u>	<u>April 27 1847</u>	<u>27</u>	<u>31</u>	<u>of 1847</u>

The above Map of Township No. 30 North of Range No. 15 West of the Principal Meridian - Michigan, is strictly conformable to the field notes of the survey thereof on file in this office, which have been examined and approved.

Surveyor General's Office,
Sault Ste. Marie, Mich. 14 1848

Lucius Logie
Surveyor General

Measure 5-22-74

17-29
B. H. ...

